

CHAPTER 10

SCHEMATIC / PARTS LISTS / SPARE PARTS LISTS

**UNINTERRUPTIBLE POWER SUPPLY (UPS),
Type: PEW 1060-220/220-EN**


TABLE OF CONTENTS:

SCHEMATIC

—▶ see SCHEMATIC DIAGRAM 1100322002/00

PARTS LISTS & SPARE PARTS LISTS

—▶ see «CUSTOMER PARTS LIST» 1100322002/50

	Revision 1 (A)	Revision 2 (B)	Revision 3 (C)	Revision 4 (D)	Revision 5 (E)	Revision 6 (F)	Revision 7 (G)
prepared: Dat./Vis.	10-11-11 mp						
approved: Dat./Vis.	10-11-11 HLU						
released: Dat./Vis.	10-11-11						
arised from: 7RA9005GB				Client Ref.: -			
 GUTOR Electronic LLC Wettingen / Switzerland				4A-1100322002/20GB			
				Rev.	Page		
				1	1 / 1		

GUTOR

by Schneider Electric

DOCUMENT TITLE : 1100322002/00

CLIENT : QINGDAO HENGHUA

PROJECT NAME : SHANDONG HAIHUA THERMAL PP

P. O. : HB03-10111

APPLICABLE FOR :

EQUIPMENT No. : TYPE :
PEW 1060-220/220-EN

RESPECT PROTECTIVE NOTE ISO 16016

		DATE	09.08.10			GUTOR by Schneider Electric	TYPE : PEW 1060-220/220-EN			AS BUILT		
		DRAWN	WWA				GENERAL COVER SHEET					
1	15.11.10	WWA	DATE	15.11.10					DOC. NO.	1100322002/00	CHAPTER	PAGE
REV.	DESCRIPTION	DATE	NAME	CHECK	HLU	SUBST. FOR :	INT. CNT. :			00	1/3	

PROJECT INFO															REVISION				PROJECT		CHECK		FIRST ISSUE	
DOCUMENT NO.	CHAPTER	PAGE	CHAPTER DESCRIPTION		PAGE DESCRIPTION		NO.	DATE	DRAWN	DESCRIPTION	STATUS	DATE	CHECKED	DATE	DRAWN									
1100322002/00	00	1	GENERAL		COVER SHEET		1	15.11.10	WWA		AS BUILT	15.11.10	HLU	09.08.10	WWA									
1100322002/00	00	2	GENERAL		TABLE OF CONTENTS		1	15.11.10	WWA	MODIFIED	AS BUILT	15.11.10	HLU	09.08.10	WWA									
1100322002/00	00	3	GENERAL		TABLE OF CONTENTS		1	15.11.10	WWA	MODIFIED	AS BUILT	15.11.10	HLU	09.08.10	WWA									
1100322002/00	01	1	LAYOUT		GENERAL ARRANGEMENT		1	15.11.10	WWA		AS BUILT	15.11.10	HLU	09.08.10	WWA									
1100322002/00	01	2	LAYOUT		SOCKET DETAIL		1	15.11.10	WWA		AS BUILT	15.11.10	HLU	09.08.10	WWA									
1100322002/00	01	3	LAYOUT		FRONTVIEW - CONTROL AND MONITORING		1	15.11.10	WWA		AS BUILT	15.11.10	HLU	09.08.10	WWA									
1100322002/00	01	4	LAYOUT		NAMEPLATES AND LIST OF LABELS		1	15.11.10	WWA		AS BUILT	15.11.10	HLU	09.08.10	WWA									
1100322002/00	01	5	LAYOUT		NAMEPLATES AND LIST OF LABELS		1	15.11.10	WWA		AS BUILT	15.11.10	HLU	09.08.10	WWA									
1100322002/00	03	1	SINGLE LINE DIAGRAM		UPS		1	15.11.10	WWA		AS BUILT	15.11.10	HLU	09.08.10	WWA									
1100322002/00	03	2	SINGLE LINE DIAGRAM		LEGEND		1	15.11.10	WWA		AS BUILT	15.11.10	HLU	09.08.10	WWA									
1100322002/00	04	1	CONNECTION DIAGRAM		TERMINAL LEGEND		1	15.11.10	WWA		AS BUILT	15.11.10	HLU	09.08.10	WWA									
1100322002/00	04	2	CONNECTION DIAGRAM		-X001 / MAINS INPUT		1	15.11.10	WWA		AS BUILT	15.11.10	HLU	09.08.10	WWA									
1100322002/00	04	3	CONNECTION DIAGRAM		-X002 / BATTERY INPUT		1	15.11.10	WWA		AS BUILT	15.11.10	HLU	09.08.10	WWA									
1100322002/00	04	4	CONNECTION DIAGRAM		-A025 EXT.CONN.BOARD		1	15.11.10	WWA		AS BUILT	15.11.10	HLU	09.08.10	WWA									
1100322002/00	04	5	CONNECTION DIAGRAM		-A075 DATA CONVERTER : RS485		1	15.11.10	WWA		AS BUILT	15.11.10	HLU	09.08.10	WWA									
1100322002/00	04	6	CONNECTION DIAGRAM		-A077 RELAY BOARD		1	15.11.10	WWA		AS BUILT	15.11.10	HLU	09.08.10	WWA									
1100322002/00	04	7	CONNECTION DIAGRAM		-A078 RELAY BOARD		1	15.11.10	WWA		AS BUILT	15.11.10	HLU	09.08.10	WWA									
1100322002/00	04	8	CONNECTION DIAGRAM		-X090 / BYPASS MAINS INPUT		1	15.11.10	WWA		AS BUILT	15.11.10	HLU	09.08.10	WWA									
1100322002/00	04	9	CONNECTION DIAGRAM		-X004 / UPS OUTPUT		1	15.11.10	WWA		AS BUILT	15.11.10	HLU	09.08.10	WWA									
1100322002/00	05	1	WIRING DIAGRAM		UPS		1	15.11.10	WWA		AS BUILT	15.11.10	HLU	09.08.10	WWA									
1100322002/00	05	2	WIRING DIAGRAM		UPS		1	15.11.10	WWA		AS BUILT	15.11.10	HLU	09.08.10	WWA									
1100322002/00	05	3	WIRING DIAGRAM		UPS		1	15.11.10	WWA		AS BUILT	15.11.10	HLU	09.08.10	WWA									
1100322002/00	05	4	WIRING DIAGRAM		UPS		1	15.11.10	WWA		AS BUILT	15.11.10	HLU	09.08.10	WWA									
1100322002/00	05	5	WIRING DIAGRAM		UPS		1	15.11.10	WWA		AS BUILT	15.11.10	HLU	09.08.10	WWA									
1100322002/00	05	6	WIRING DIAGRAM		UPS		1	15.11.10	WWA		AS BUILT	15.11.10	HLU	09.08.10	WWA									
1100322002/00	05	7	WIRING DIAGRAM		UPS		1	15.11.10	WWA		AS BUILT	15.11.10	HLU	09.08.10	WWA									
1100322002/00	07	1	WIRING DIAGRAM		INCOMING / BYPASS		1	15.11.10	WWA		AS BUILT	15.11.10	HLU	09.08.10	WWA									
1100322002/00	07	2	WIRING DIAGRAM		STABILIZER		1	15.11.10	WWA		AS BUILT	15.11.10	HLU	09.08.10	WWA									
1100322002/00	07	3	WIRING DIAGRAM		STABILIZER		1	15.11.10	WWA		AS BUILT	15.11.10	HLU	09.08.10	WWA									
1100322002/00	07	4	WIRING DIAGRAM		INCOMING / BYPASS		1	15.11.10	WWA		AS BUILT	15.11.10	HLU	09.08.10	WWA									

RESPECT PROTECTIVE NOTE ISO 16016

DATE	09.08.10
DRAWN	WWA
DATE	15.11.10
REV.	1
DESCRIPTION	MODIFIED
DATE	15.11.10
NAME	WWA
CHECK	HLU



SUBST. FOR : INT. CNT. :




TYPE : PEW 1060-220/220-EN
GENERAL
TABLE OF CONTENTS

AS BUILT
DOC. NO. 1100322002/00
CHAPTER PAGE
00 2/3


RESPECT PROTECTIVE NOTE ISO 16016

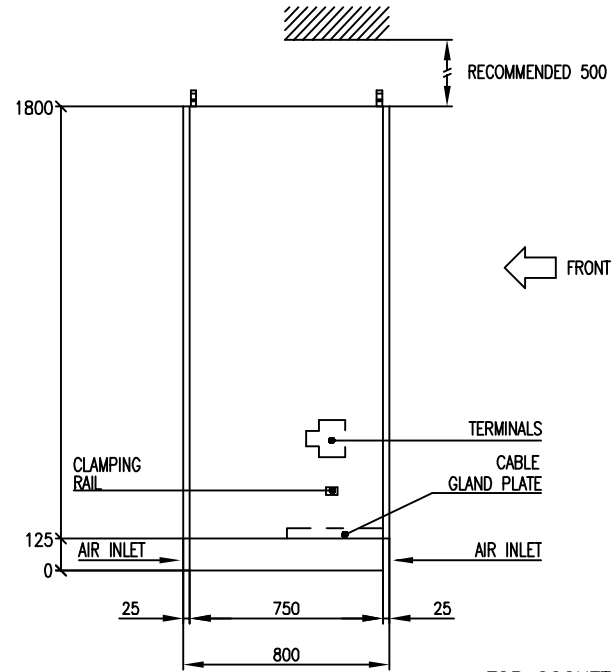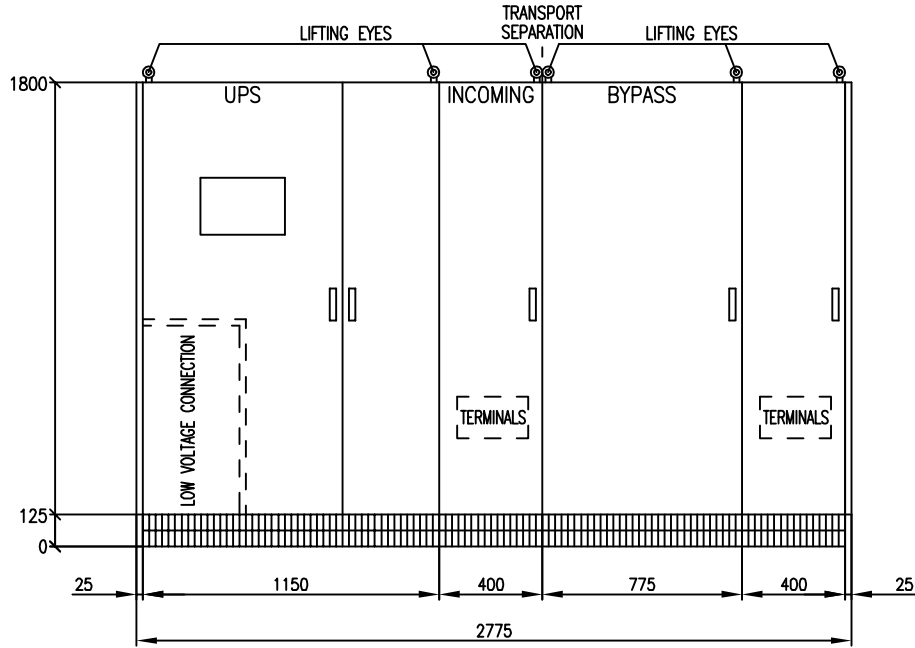

FOR SOCKET DETAIL SEE PAGE 2

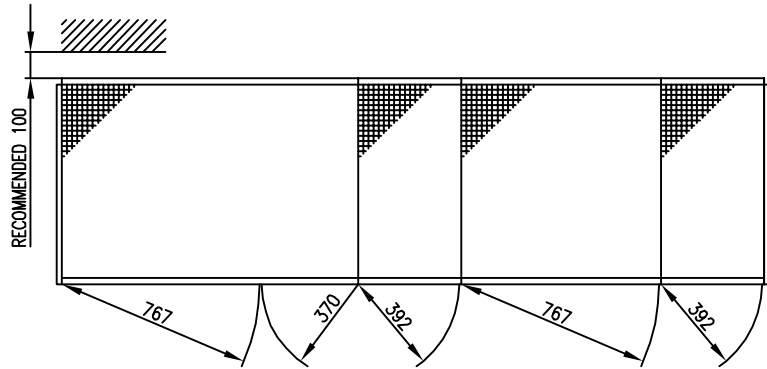

↑
FRONT

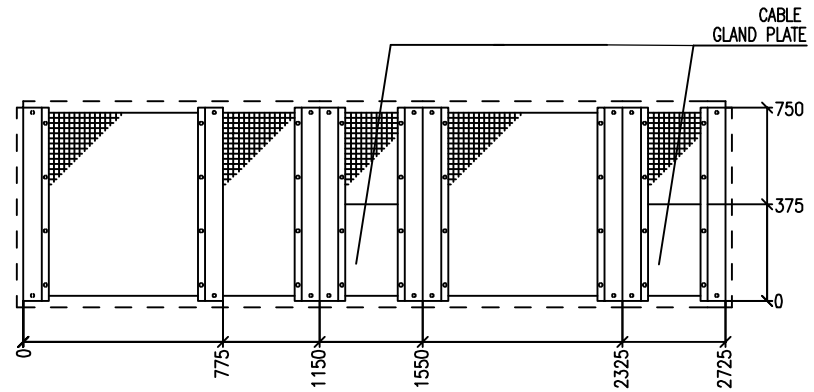

↑
FRONT

PROTECTION CLASS : IP20
COLOUR : RAL7032
WEIGHT : 1910kg

			DATE	09.08.10
			DRAWN	WWA
1		15.11.10	DATE	15.11.10
REV.	DESCRIPTION	DATE	NAME	CHECK
			HLU	

SUBST. FOR : INT. CNT. :



TYPE : PEW 1060-220/220-EN
LAYOUT
GENERAL ARRANGEMENT

SCALE
1 : 20





AS BUILT



DOC. NO. 1100322002/00

CHAPTER PAGE
01 1/5

RESPECT PROTECTIVE NOTE ISO 16016

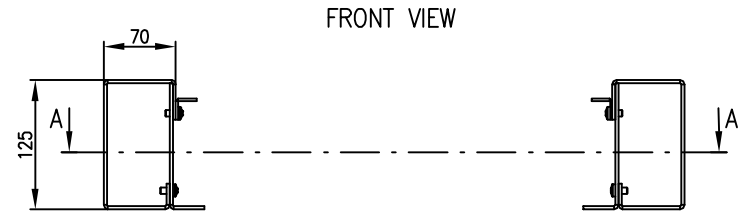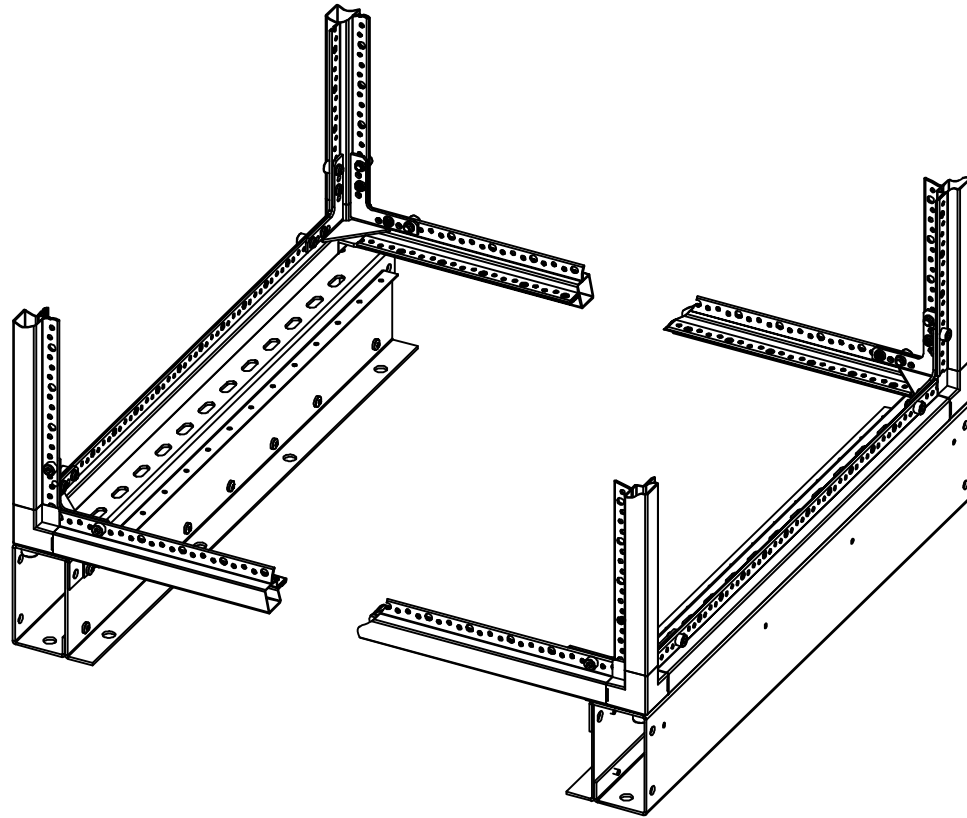

A-A

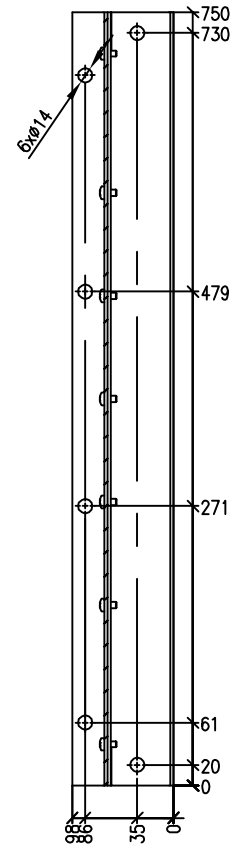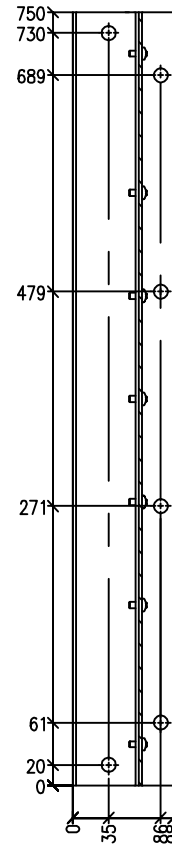

			DATE	09.08.10
			DRAWN	WWA
1		15.11.10	DATE	15.11.10
REV.	DESCRIPTION	DATE	NAME	CHECK
			HLU	

SUBST. FOR : INT. CNT. :

GUTOR
by Schneider Electric

TYPE : PEW 1060-220/220-EN
LAYOUT
SOCKET DETAIL


SCALE
1 : 5

AS BUILT

DOC. NO. 1100322002/00

CHAPTER PAGE
01 2 / 5

RESPECT PROTECTIVE NOTE ISO 16016

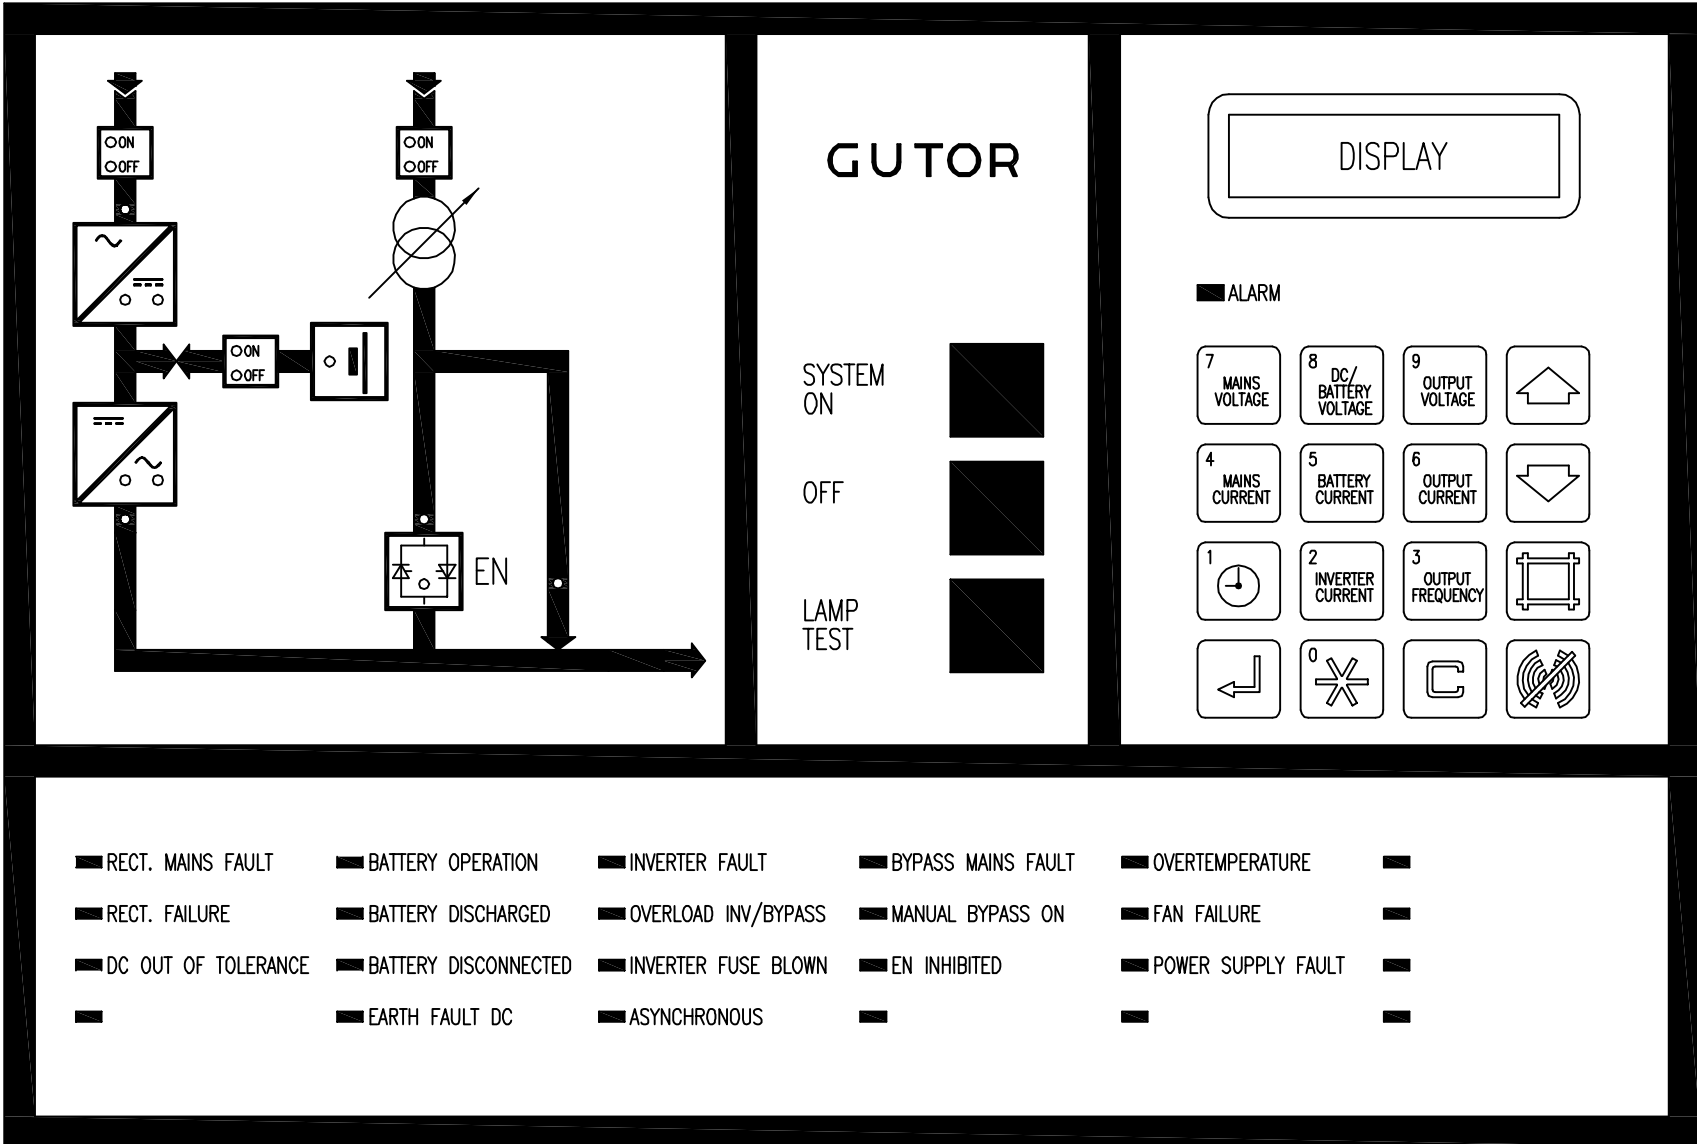

- | | | | | | |
|-----------------------|------------------------|-----------------------|----------------------|----------------------|---|
| ■ RECT. MAINS FAULT | ■ BATTERY OPERATION | ■ INVERTER FAULT | ■ BYPASS MAINS FAULT | ■ OVERTEMPERATURE | ■ |
| ■ RECT. FAILURE | ■ BATTERY DISCHARGED | ■ OVERLOAD INV/BYPASS | ■ MANUAL BYPASS ON | ■ FAN FAILURE | ■ |
| ■ DC OUT OF TOLERANCE | ■ BATTERY DISCONNECTED | ■ INVERTER FUSE BLOWN | ■ EN INHIBITED | ■ POWER SUPPLY FAULT | ■ |
| ■ | ■ EARTH FAULT DC | ■ ASYNCHRONOUS | ■ | ■ | ■ |

			DATE	09.08.10
			DRAWN	WWA
1	15.11.10	WWA	DATE	15.11.10
REV.	DESCRIPTION	DATE	NAME	CHECK
			HLU	

SUBST. FOR : INT. CNT. :



TYPE : PEW 1060-220/220-EN
LAYOUT
FRONTVIEW - CONTROL AND MONITORING

AS BUILT
DOC. NO. 1100322002/00

SYSTEM RATING PLATE

A

A

B

B

C

C

D

D

E

E

F

F

RESPECT PROTECTIVE NOTE ISO 16016

ADHESIVE STICKER
885-4777

GUTOR		Schneider (Beijing) Medium Voltage Co.,Ltd Beijing / China					
by Schneider Electric		UPS					
Type	PEW 1060-220/220-EN					No. 1100322002-01	
Input	3x380	V	148.1	A	AC	50 Hz	97.5 kVA 80.9 kW
Output	1x220	V	272.7	A	AC	50 Hz	60.0 kVA 48.0 kW
IP	IP20		Year 2010		Refer to Operating Instructions for further details		

ADHESIVE STICKER
885-4777

GUTOR		Schneider (Beijing) Medium Voltage Co.,Ltd Beijing / China					
by Schneider Electric		BYPASS					
Type	PEW 1060-220/220-EN					No. 1100322002-02	
Input	V	A	AC	Hz	kVA	kW	
Output	V	A	AC	Hz	kVA	kW	
IP	IP20		Year 2010		Refer to Operating Instructions for further details		

		DATE	09.08.10			GUTOR	TYPE : PEW 1060-220/220-EN			AS BUILT		
		DRAWN	WWA				by Schneider Electric	LAYOUT			DOC. NO.	1100322002/00
1	15.11.10	WWA	DATE	15.11.10			NAMEPLATES AND LIST OF LABELS					01 4 / 5
REV.	DESCRIPTION	DATE	NAME	CHECK	HLU	SUBST. FOR :	INT. CNT. :					
1								3		4		5

1 2 3 4 5 6 7 8

SYSTEM LABEL

BLACK LETTERING ON A WHITE BACKGROUND
4628.800

WHITE LETTERING ON A BLACK BACKGROUND
4628.801

UPS

INCOMING

BYPASS

RESPECT PROTECTIVE NOTE ISO 16016

			DATE	09.08.10
			DRAWN	WWA
1		15.11.10	DATE	15.11.10
REV.	DESCRIPTION	DATE	NAME	CHECK
			HLU	

SUBST. FOR : INT. CNT. :



TYPE : PEW 1060-220/220-EN

LAYOUT
NAMEPLATES AND LIST OF LABELS

AS BUILT


DOC. NO. 1100322002/00

CHAPTER PAGE
01 5/5

1 2 3 4 5 6 7 8

RESPECT PROTECTIVE NOTE ISO 16016

V/A/F MEASUREMENTS TO BE READ ON THE DISPLAY

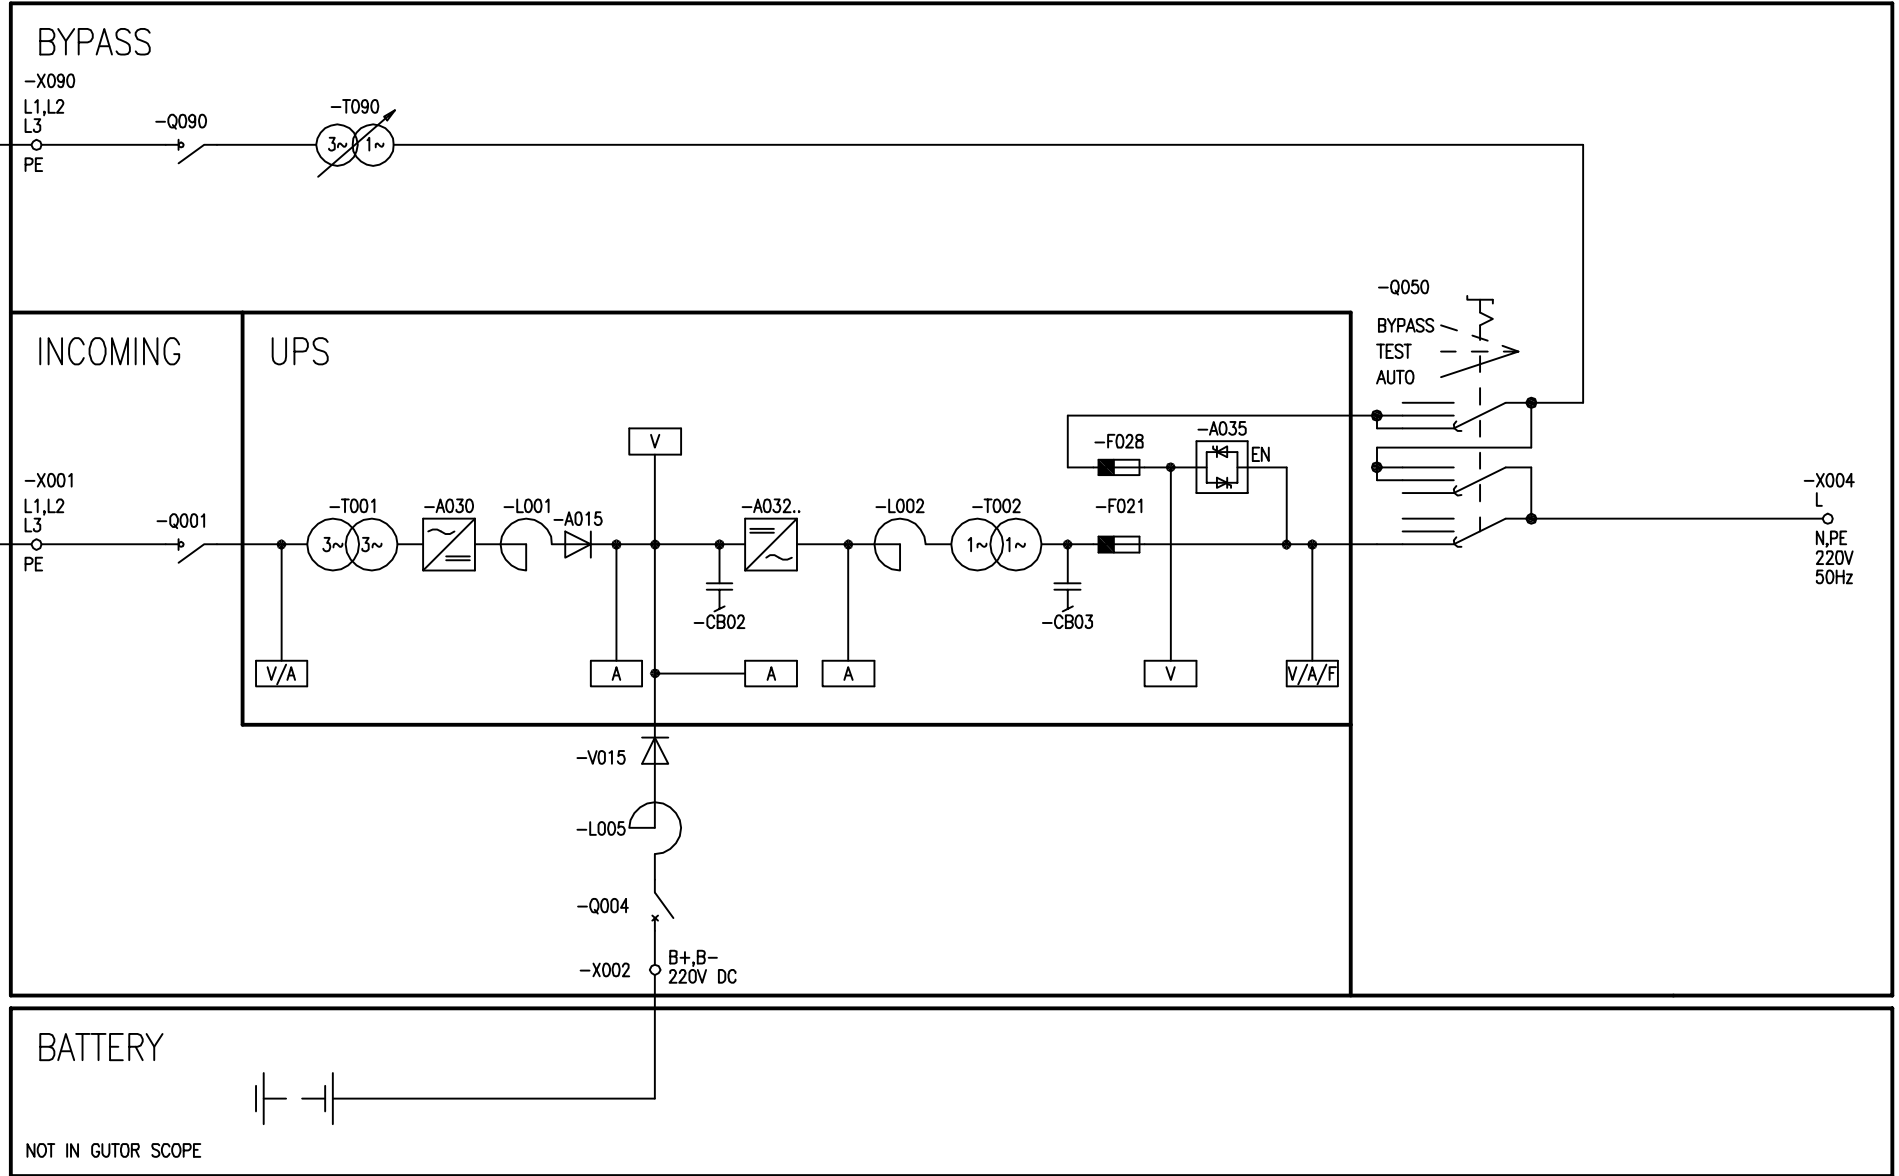

DATE	09.08.10
DRAWN	WWA
DATE	15.11.10
NAME	WWA
CHECK	HLU







TYPE : PEW 1060-220/220-EN
SINGLE LINE DIAGRAM
UPS

AS BUILT	
DOC. NO.	1100322002/00
CHAPTER	03
PAGE	1/2

REV.	DESCRIPTION	DATE	NAME	CHECK	HLU	SUBST. FOR :	INT. CNT. :
1		15.11.10	WWA				

RESPECT PROTECTIVE NOTE ISO 16016

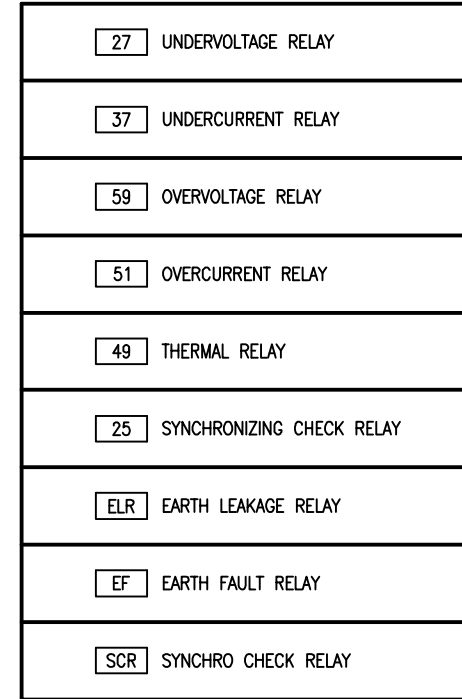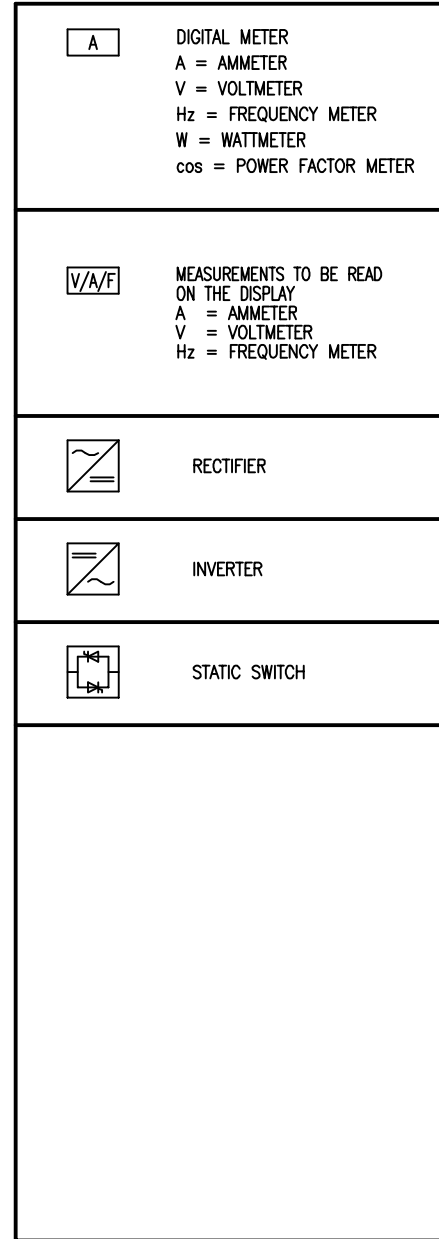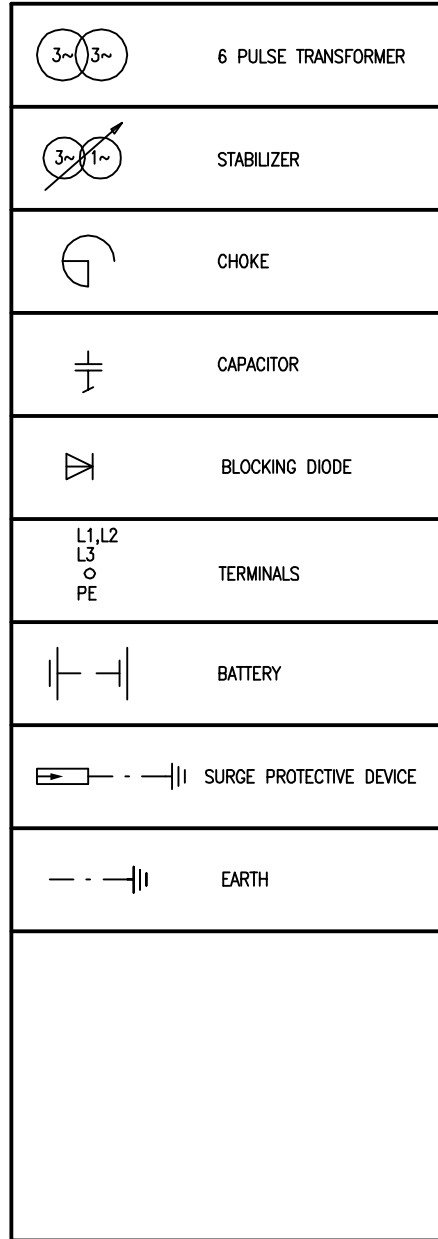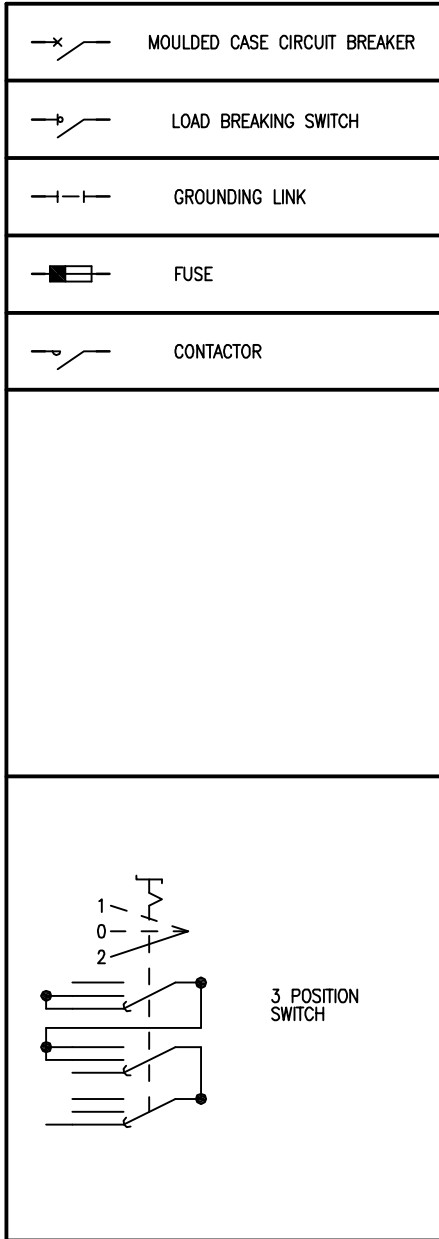

EQUIPMENT CODE	
CODE	DESCRIPTION
A	ASSEMBLIES , VARIOUS BOARDS
B	SENSOR , FIRE DETECTOR
C	CAPACITOR , STORAGE DEVICES
F	FUSE , PROTECTION DEVICES
G	GENERATOR
H	SIGNAL LAMP , LIGHTING
K	CONTACTOR , RELAY , FILTER
M	MOTOR
P	DISPLAY UNIT
Q	SWITCHING DEVICES FOR POWER CIRCUIT
R	RESISTOR
S	SELECTOR SWITCH , CONTROL SWITCHES
T	CONVERTER , TRANSFORMER , TRANSDUCER
W	BUS BAR
X	TERMINALS , PLUGS

DATE	09.08.10
DRAWN	WWA
DATE	15.11.10
15.11.10	WWA
DATE	15.11.10
REV.	DESCRIPTION
1	15.11.10 WWA

DATE	09.08.10
DRAWN	WWA
DATE	15.11.10
15.11.10	WWA
DATE	15.11.10
REV.	DESCRIPTION
1	15.11.10 WWA



TYPE : PEW 1060-220/220-EN
SINGLE LINE DIAGRAM
LEGEND

AS BUILT	CHAPTER PAGE
DOC. NO. 1100322002/00	03 2/2

TERMINAL LEGEND

POWER TERMINAL INFORMATION X001/X002/X004 & X090					
CURRENT	SIZE	TYPE	BOLT	CABLE	DIMENSION
UP TO 115A	35mm ²	BOLT TERMINAL	M6	6-35mm ²	
UP TO 185A	70mm ²	BOLT TERMINAL	M8	35-70mm ²	
UP TO 265A	120mm ²	BOLT TERMINAL	M10	70-120mm ²	
UP TO 350A	185mm ²	BOLT TERMINAL	M12	120-185mm ²	
UP TO 500A	300mm ²	BOLT TERMINAL	M16	185-300mm ²	
UP TO 440A	2x240mm ²	CU-BAR	M12	2x240mm ²	DETAIL A
UP TO 800A	4x240/2x300mm ²	CU-BAR	M12/16	4x240/2x300mm ²	DETAIL B
UP TO 1200A	8x240/4x300mm ²	CU-BAR	M12/16	8x240/4x300mm ²	DETAIL C


DISTRIBUTION TERMINALS INFORMATION			
CURRENT	SIZE	TYPE	CABLE
UP TO 41A	6mm ²	FEEDTHROUGH TERMINAL	0.5-6mm ²
UP TO 57A	10mm ²	FEEDTHROUGH TERMINAL	1.5-16mm ²
UP TO 76A	16mm ²	FEEDTHROUGH TERMINAL	1.5-16mm ²
UP TO 115A	35mm ²	FEEDTHROUGH TERMINAL	2.5-35mm ²
UP TO 192A	70mm ²	FEEDTHROUGH TERMINAL	10-70mm ²
UP TO 269A	120mm ²	FEEDTHROUGH TERMINAL	16-120mm ²

CONTROL TERMINALS	
SIZE	TYPE
2.5mm ²	FEEDTHROUGH TERMINAL
4mm ²	FEEDTHROUGH TERMINAL


INFORMATION GENERAL EARTH

IF NO INDIVIDUAL EARTH TERMINAL IS AVAILABLE,
THEN THE PE CONDUCTORS OF THE CABLES SHALL BE
CONNECTED TO THE GENERAL EARTH BAR


DIMENSION : DETAIL A

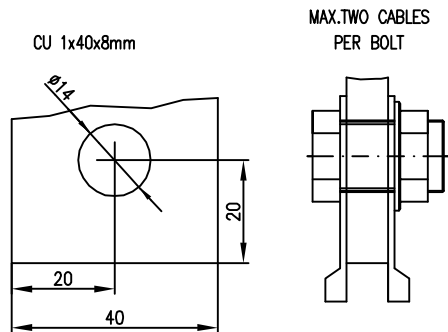

DIMENSION : DETAIL B

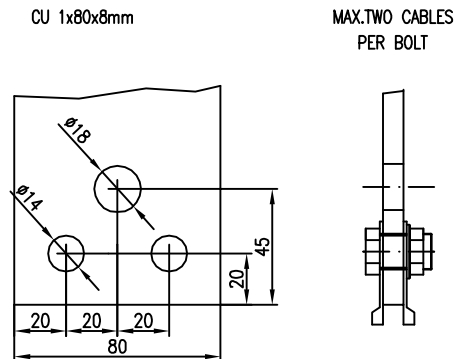

DIMENSION : DETAIL C

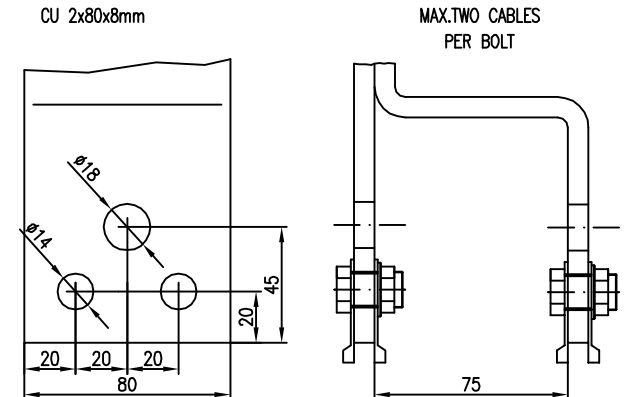

RESPECT PROTECTIVE NOTE ISO 16016

DATE	09.08.10
DRAWN	WWA
DATE	15.11.10
CHECK	HLU

GUTOR
by Schneider Electric

TYPE : PEW 1060-220/220-EN
CONNECTION DIAGRAM
TERMINAL LEGEND

AS BUILT

DOC. NO. 1100322002/00

CHAPTER PAGE
04 1/9

A
B
C
D
E
F

A
B
C
D
E
F

TERMINAL INFORMATION :

CHAPTER : =05
 TERMINALS : -X001

CUSTOMER :

SIZE	CURRENT A	TYPE	TERMINALS DESCRIPTION	PAGE	TERMINAL	NOTES
70mm ²	UP TO 185A	M8 BOLT TERMINAL	MAINS INPUT 3x380V,50Hz 3PH, 3W	1.1F	X001:L1	
70mm ²	UP TO 185A	M8 BOLT TERMINAL		1.1F	X001:L2	
70mm ²	UP TO 185A	M8 BOLT TERMINAL		1.2F	X001:L3	
		EARTH BAR		1.2F	X001:PE	

RESPECT PROTECTIVE NOTE ISO 16016

	1	2	3	4	5	6	7	8	
A	TERMINAL INFORMATION :			CHAPTER : =05 TERMINALS : -X002		CUSTOMER :			
	B	SIZE	CURRENT A	TYPE	TERMINALS DESCRIPTION	PAGE	TERMINAL	NOTES	
		2x240mm ²	UP TO 440A	M12 CU-BAR	BATTERY INPUT	5.4	X002:B+		
	2x240mm ²	UP TO 440A	M12 CU-BAR	220V DC	5.5	X002:B-			
C	RESPECT PROTECTIVE NOTE ISO 16016								
D									
E									
F									



1	15.11.10	WWA	DATE	15.11.10						
REV.	DESCRIPTION	DATE	NAME	CHECK	HLU	SUBST. FOR :	INT. CNT. :			

TYPE : PEW 1060-220/220-EN		AS BUILT			
CONNECTION DIAGRAM				DOC. NO. 1100322002/00	
-X002 / BATTERY INPUT				CHAPTER PAGE 04 3/9	

1	2		3		4		5		6		7		8	
A	CHAPTER : =05			TERMINAL DESCRIPTION		PAGE	TERMINAL	DESCRIPTION						A
	EXT.CONN.BOARD : -A025			COMMON ALARM		17.1	-X001:11							
B	TYPE	CONNECTION		COMMON ALARM (NC)		17.1	-X001:12							
	2.5mm ²	FEEDTHROUGH TERMINAL		COMMON ALARM (NO)		17.2	-X001:14							
C				COMMON ALARM		17.2	-X002:21							C
				COMMON ALARM (NC)		17.2	-X002:22							
D				COMMON ALARM (NO)		17.2	-X002:24							D
				BATTERY OPERATION		17.3	-X003:31							
E				BATTERY OPERATION (NC)		17.3	-X003:32							E
				BATTERY OPERATION (NO)		17.3	-X003:34							
F				EXT. CONTACT BYPASS		17.4	-X004:41							F
				EXT. CONTACT BYPASS (NC)		17.4	-X004:42							
F				EXT. CONTACT BYPASS (NO)		17.4	-X004:44							F
				REMOTE (ON)		17.4	-X005:1							
F				REMOTE (OFF)		17.5	-X005:2							F
				REMOTE (GND)		17.5	-X005:3							
F				NOT USED		17.7	-X006:1							F
				NOT USED		17.7	-X006:2							
F				NOT USED		17.7	-X006:3	INTERNAL CONNECTION TO EXT.CONN.BOARD -A025 -X006:4						F
				NOT USED		17.7	-X006:4							
F				TEMPERATURE		17.7	-X007:1	INTERNAL CONNECTION TO EXT.CONN.BOARD -A025 -X007:2						F
				TEMPERATURE		17.7	-X007:2							
F				TEMP.COMP. (+)		17.8	-X007:3	INTERNAL CONNECTION TO EXT.CONN.BOARD -A025 -X007:1						F
				TEMP.COMP. (-)		17.8	-X007:4							
F				NOT USED		17.5	-X008:1							F
				NOT USED		17.5	-X008:2							
F				NOT USED		17.5	-X008:3							F
				NOT USED		17.6	-X008:4							
F				NOT USED		17.6	-X009:1							F
				NOT USED		17.6	-X009:2							
F				NOT USED		17.6	-X009:3							F
				NOT USED		17.6	-X009:4							
F				NOT USED		17.6	-X011:1							F
				NOT USED		17.6	-X011:2							
F				NOT USED		17.6	-X011:3							F
				NOT USED		17.7	-X011:4							
F														F
DATE	09.08.10		DRAWN		WWA		TYPE : PEW 1060-220/220-EN		AS BUILT		CHAPTER PAGE			
1	15.11.10	WWA	DATE	15.11.10	CONNECTION DIAGRAM		-A025 EXT.CONN.BOARD		DOC. NO. 1100322002/00		04 4 / 9			
REV.	DESCRIPTION	DATE	NAME	CHECK	HLU	SUBST. FOR :	INT. CNT. :							
1														

RESPECT PROTECTIVE NOTE ISO 16016



	1	2	3	4	5	6	7	8
A	CHAPTER : =05 DATA CONVERTER : -A075		TERMINAL DESCRIPTION	PAGE	TERMINAL	DESCRIPTION		
B	TYPE CONNECTION		RS485					
	2.5mm ² FEEDTHROUGH TERMINAL							
C								
D								
E								
F								
RESPECT PROTECTIVE NOTE ISO 16016		DATE	09.08.10	TYPE : PEW 1060-220/220-EN			AS BUILT	
		DRAWN	WWA					
1	15.11.10	WWA	DATE	15.11.10	DOC. NO. 1100322002/00			CHAPTER PAGE
REV.	DESCRIPTION	DATE	NAME	CHECK				HLU
	1		2		3		4	5
								6
								7
								8



TYPE : PEW 1060-220/220-EN
CONNECTION DIAGRAM
-A075 DATA CONVERTER : RS485

DOC. NO. 1100322002/00

CHAPTER PAGE
04 5/9

1 2 3 4 5 6 7 8

CHAPTER : =05
 RELAY BOARD : -A077

TYPE	CONNECTION
2.5mm ²	FEEDTHROUGH TERMINAL

TERMINAL DESCRIPTION	PAGE	TERMINAL	DESCRIPTION
RECTIFIER MAINS FAULT	18.2	X001:011	
RECTIFIER MAINS FAULT (NC)	18.2	X001:012	
RECTIFIER MAINS FAULT (NO)	18.2	X001:014	
DC OUT OF TOLERANCE	18.2	X002:021	
DC OUT OF TOLERANCE (NC)	18.3	X002:022	
DC OUT OF TOLERANCE (NO)	18.3	X002:024	
RECTIFIER FUSE BLOWN	18.3	X003:031	
RECTIFIER FUSE BLOWN (NC)	18.4	X003:032	
RECTIFIER FUSE BLOWN (NO)	18.4	X003:034	
BATTERY DISCHARGED	18.4	X004:041	
BATTERY DISCHARGED (NC)	18.4	X004:042	
BATTERY DISCHARGED (NO)	18.5	X004:044	
EARTH FAULT DC	18.5	X005:051	
EARTH FAULT DC (NC)	18.5	X005:052	
EARTH FAULT DC (NO)	18.6	X005:054	
INVERTER FUSE BLOWN	18.6	X006:061	
INVERTER FUSE BLOWN (NC)	18.6	X006:062	
INVERTER FUSE BLOWN (NO)	18.6	X006:064	
BYPASS MAINS FAULT	18.7	X007:071	
BYPASS MAINS FAULT (NC)	18.7	X007:072	
BYPASS MAINS FAULT (NO)	18.7	X007:074	
OVERTEMPERATURE	18.8	X008:081	
OVERTEMPERATURE (NC)	18.8	X008:082	
OVERTEMPERATURE (NO)	18.8	X008:084	
FAN FAILURE	19.2	X009:091	
FAN FAILURE (NC)	19.2	X009:092	
FAN FAILURE (NO)	19.2	X009:094	
POWER SUPPLY FAULT	19.2	X010:101	
POWER SUPPLY FAULT (NC)	19.3	X010:102	
POWER SUPPLY FAULT (NO)	19.3	X010:104	
OPTION 2	19.3	X011:111	
OPTION 2 (NC)	19.4	X011:112	
OPTION 2 (NO)	19.4	X011:114	
OPTION 3	19.4	X012:121	
OPTION 3 (NC)	19.4	X012:122	
OPTION 3 (NO)	19.5	X012:124	
OPTION 4	19.5	X013:131	
OPTION 4 (NC)	19.5	X013:132	
OPTION 4 (NO)	19.6	X013:134	
OPTION 5	19.6	X014:141	
OPTION 5 (NC)	19.6	X014:142	
OPTION 5 (NO)	19.6	X014:144	
OPTION 6	19.7	X015:151	
OPTION 6 (NC)	19.7	X015:152	
OPTION 6 (NO)	19.7	X015:154	
NOT USED	19.8	X016:161	
NOT USED	19.8	X016:162	
NOT USED	19.8	X016:164	

RESPECT PROTECTIVE NOTE ISO 16016

DATE	09.08.10
DRAWN	WWA
DATE	15.11.10
NAME	HLU
CHECK	



TYPE : PEW 1060-220/220-EN
 CONNECTION DIAGRAM
 -A077 RELAY BOARD

AS BUILT	
DOC. NO.	1100322002/00
CHAPTER PAGE	04 6 / 9

1 2 3 4 5 6 7 8

1		2		3		4		5		6		7		8	
CHAPTER : =05				TERMINAL DESCRIPTION				PAGE	TERMINAL	DESCRIPTION					
RELAY BOARD : -A078				EA INHIBITED				20.2	X001:011						
				EA INHIBITED (NC)				20.2	X001:012						
				EA INHIBITED (NO)				20.2	X001:014						
TYPE		CONNECTION		EN INHIBITED				20.2	X002:021						
2.5mm ²		FEEDTHROUGH TERMINAL		EN INHIBITED (NC)				20.3	X002:022						
				EN INHIBITED (NO)				20.3	X002:024						
				MANUAL BYPASS ON				20.3	X003:031						
				MANUAL BYPASS ON (NC)				20.4	X003:032						
				MANUAL BYPASS ON (NO)				20.4	X003:034						
				ASYNCHRONOUS				20.4	X004:041						
				ASYNCHRONOUS (NC)				20.4	X004:042						
				ASYNCHRONOUS (NO)				20.5	X004:044						
				OVERLOAD INV / BYPASS				20.5	X005:051						
				OVERLOAD INV / BYPASS (NC)				20.5	X005:052						
				OVERLOAD INV / BYPASS (NO)				20.6	X005:054						
				INVERTER FAULT				20.6	X006:061						
				INVERTER FAULT (NC)				20.6	X006:062						
				INVERTER FAULT (NO)				20.6	X006:064						
				BATTERY DISCONNECTED				20.7	X007:071						
				BATTERY DISCONNECTED (NC)				20.7	X007:072						
				BATTERY DISCONNECTED (NO)				20.7	X007:074						
				BATTERY OPERATION				20.8	X008:081						
				BATTERY OPERATION (NC)				20.8	X008:082						
				BATTERY OPERATION (NO)				20.8	X008:084						
				RECTIFIER FAILURE				21.2	X009:091						
				RECTIFIER FAILURE (NC)				21.2	X009:092						
				RECTIFIER FAILURE (NO)				21.2	X009:094						
				EN ON				21.2	X010:101						
				EN ON (NC)				21.3	X010:102						
				EN ON (NO)				21.3	X010:104						
				EA ON				21.3	X011:111						
				EA ON (NC)				21.4	X011:112						
				EA ON (NO)				21.4	X011:114						
				INVERTER ON				21.4	X012:121						
				INVERTER ON (NC)				21.4	X012:122						
				INVERTER ON (NO)				21.5	X012:124						
				BOOST CHARGE ON				21.5	X013:131						
				BOOST CHARGE ON (NC)				21.5	X013:132						
				BOOST CHARGE ON (NO)				21.6	X013:134						
				CHARGER ON				21.6	X014:141						
				CHARGER ON (NC)				21.6	X014:142						
				CHARGER ON (NO)				21.6	X014:144						
				NOT USED				21.7	X015:151						
				NOT USED				21.7	X015:152						
				NOT USED				21.7	X015:154						
				EXTERNAL HORN				21.8	X016:161						
				EXTERNAL HORN (NC)				21.8	X016:162						
				EXTERNAL HORN (NO)				21.8	X016:164						
		DATE 09.08.10				TYPE : PEW 1060-220/220-EN				AS BUILT					
		DRAWN WWA				CONNECTION DIAGRAM						DOC. NO. 1100322002/00		CHAPTER PAGE 04 7/9	
1	15.11.10	WWA	DATE 15.11.10			-A078 RELAY BOARD									
REV.	DESCRIPTION	DATE	NAME	CHECK	HLU	SUBST. FOR :	INT. CNT. :								

RESPECT PROTECTIVE NOTE ISO 16016



1

2

3

4

5

6

7

8

TERMINAL INFORMATION :

CHAPTER : =07
TERMINALS : -X004

CUSTOMER :

SIZE	CURRENT A	TYPE	TERMINALS DESCRIPTION	PAGE	TERMINAL	NOTES
185mm ²	UP TO 350A	M12 BOLT TERMINAL	UPS OUTPUT 1x220V, AC	5.4	X004:L	
185mm ²	UP TO 350A	M12 BOLT TERMINAL		5.5	X004:N	
		EARTH BAR		5.5	X004:PE	

RESPECT PROTECTIVE NOTE ISO 16016

A

B

C

D

F

F

A

B

C


D

E

F



RESPECT PROTECTIVE NOTE ISO 16016

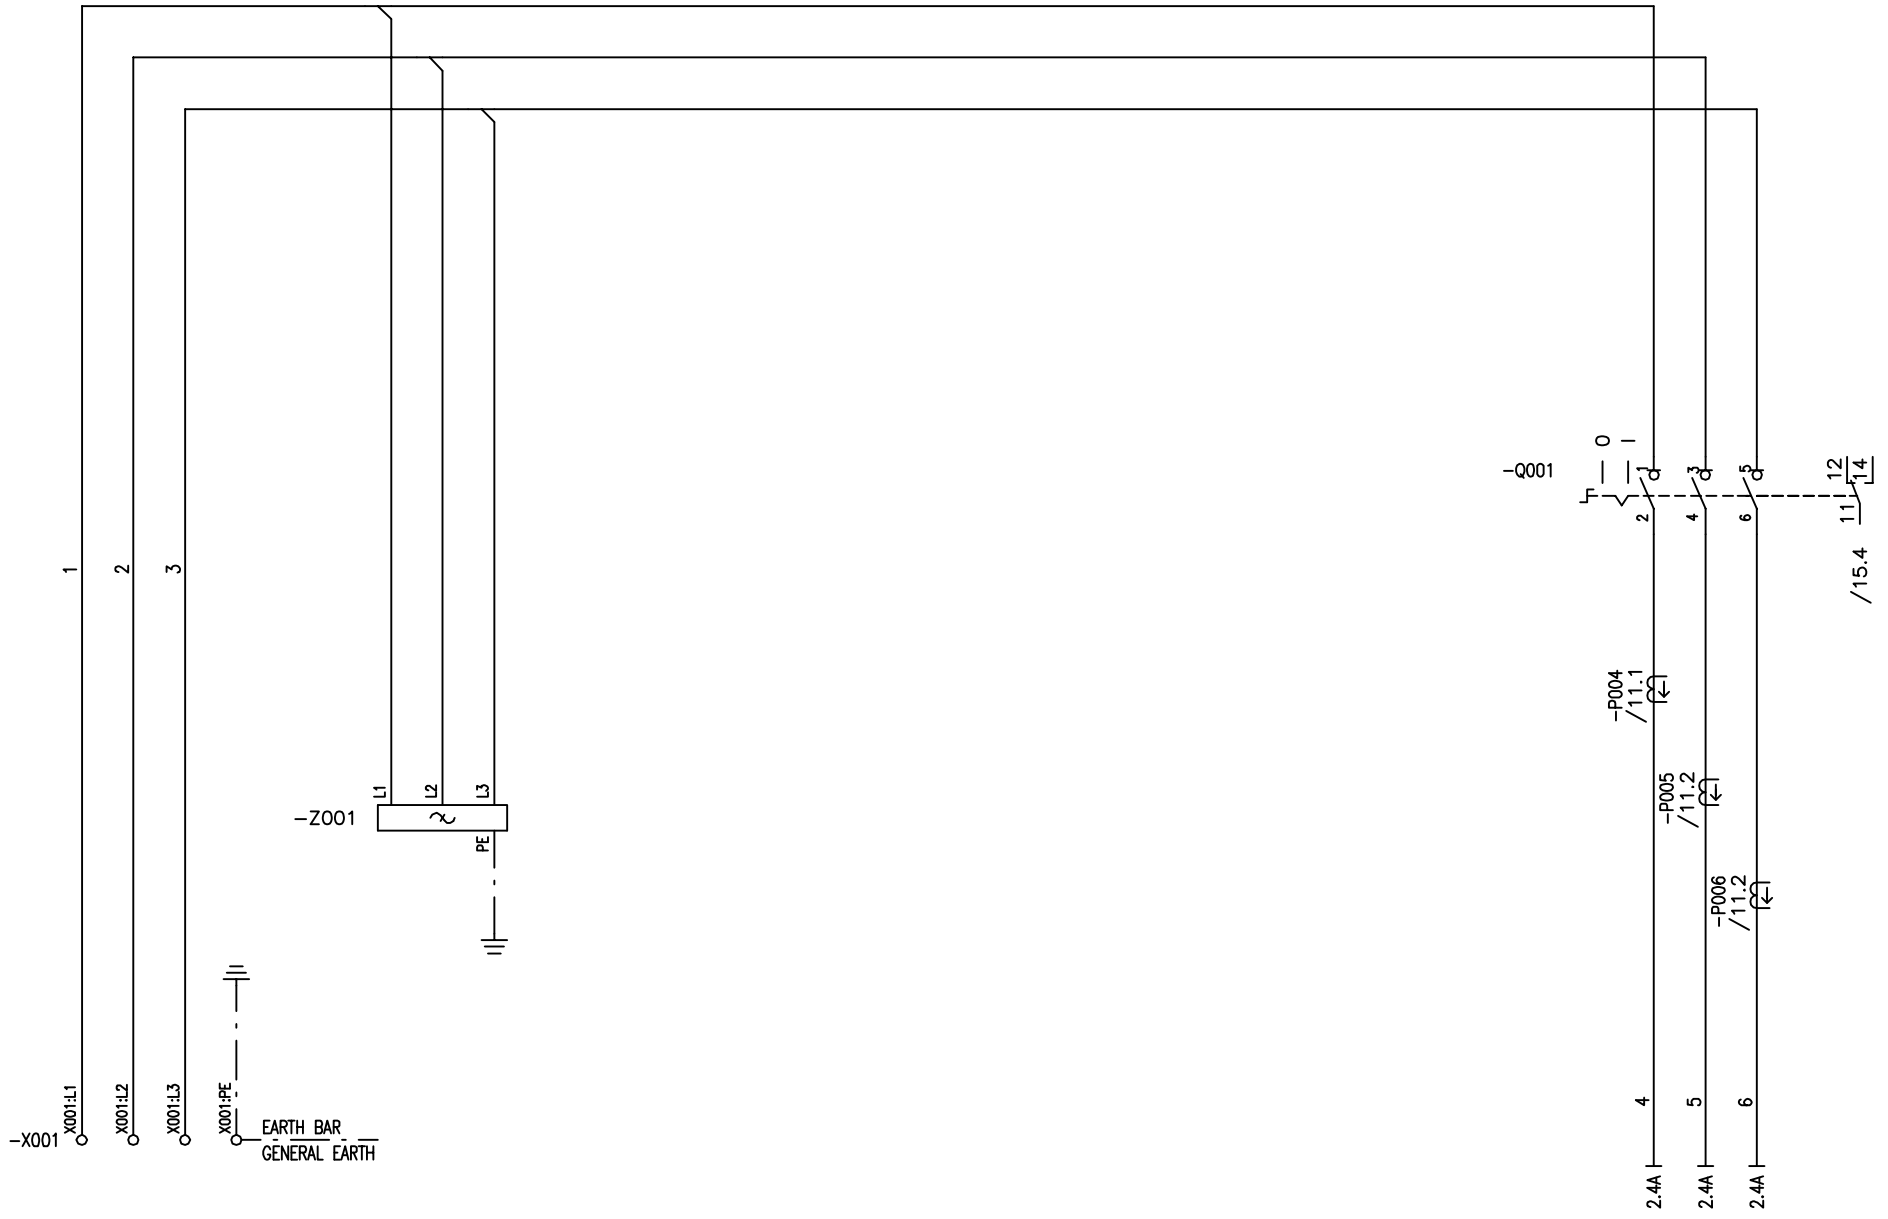


		DATE	09.08.10			TYPE : PEW 1060-220/220-EN		AS BUILT			
		DRAWN	WWA			WIRING DIAGRAM					
1	15.11.10	NAME	WWA	DATE	15.11.10			DOC. NO.		1100322002/00	
REV.	DESCRIPTION	DATE	CHECK	HLU	SUBST. FOR :	INT. CNT. :			CHAPTER		PAGE
1									05		1/23



UPS

RESPECT PROTECTIVE NOTE ISO 16016

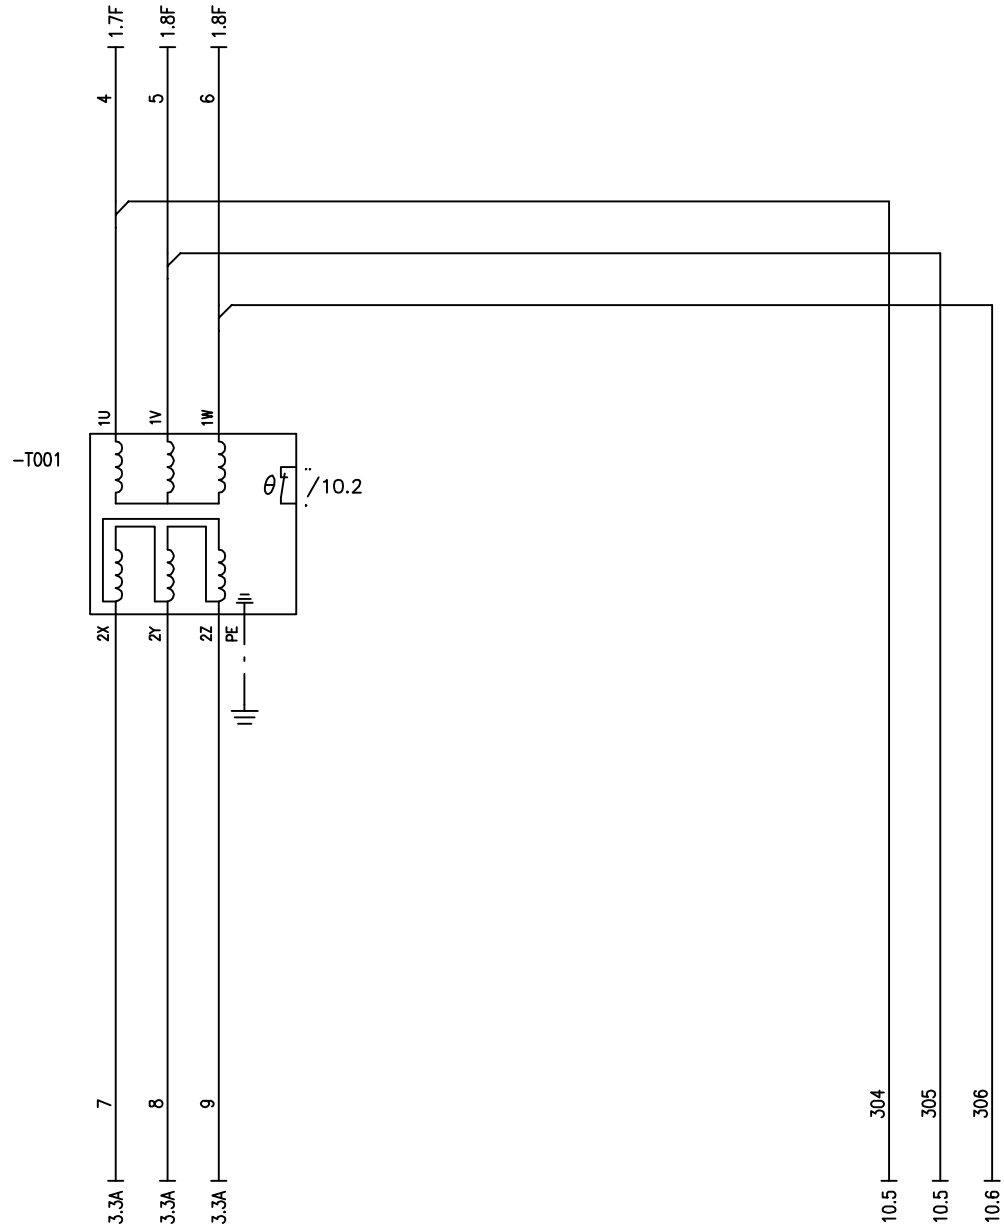

			DATE	09.08.10
			DRAWN	WWA
1		15.11.10	DATE	15.11.10
REV.	DESCRIPTION	DATE	NAME	CHECK
			HLU	

SUBST. FOR : INT. CNT. :




TYPE : PEW 1060-220/220-EN
WIRING DIAGRAM
UPS

AS BUILT
DOC. NO. 1100322002/00

CHAPTER PAGE
05 2 / 23

RESPECT PROTECTIVE NOTE ISO 16016

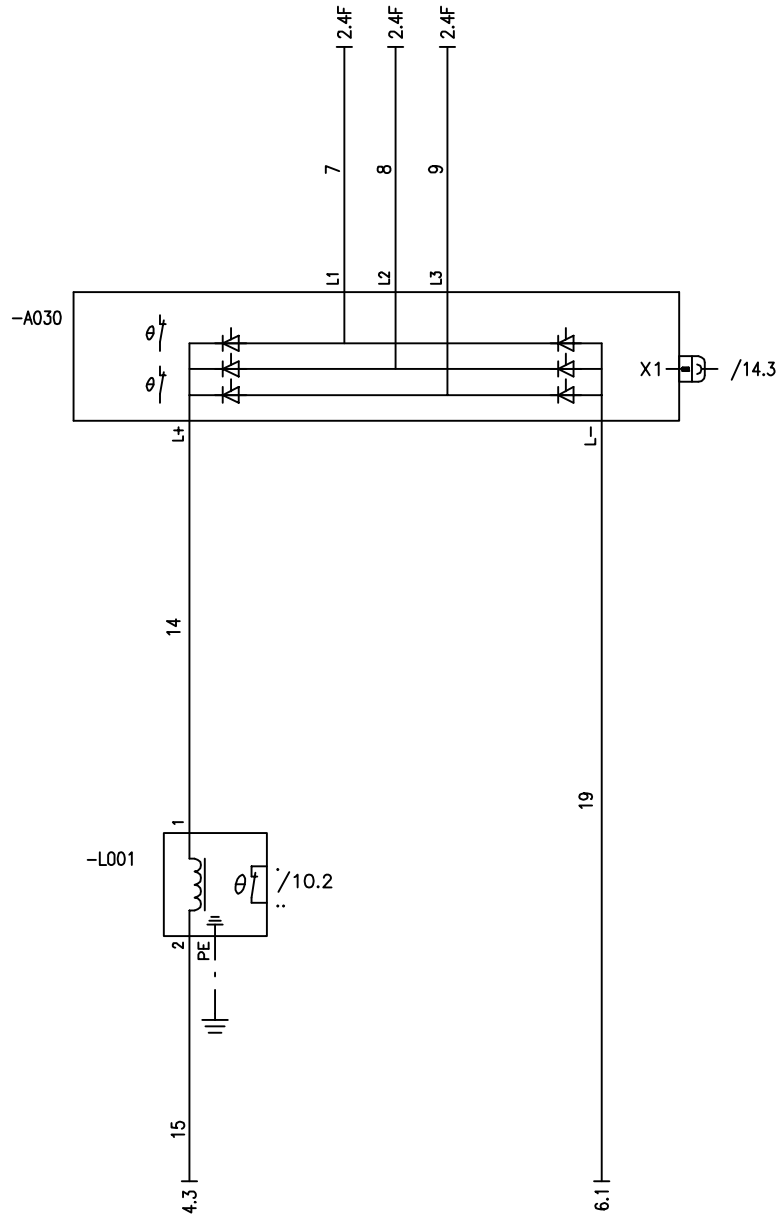

			DATE	09.08.10
			DRAWN	WWA
1		15.11.10	DATE	15.11.10
REV.	DESCRIPTION	DATE	NAME	CHECK
			HLU	


SUBST. FOR : INT. CNT. :



TYPE : PEW 1060-220/220-EN
WIRING DIAGRAM
UPS


AS BUILT
DOC. NO. 1100322002/00

CHAPTER PAGE
05 3 / 23

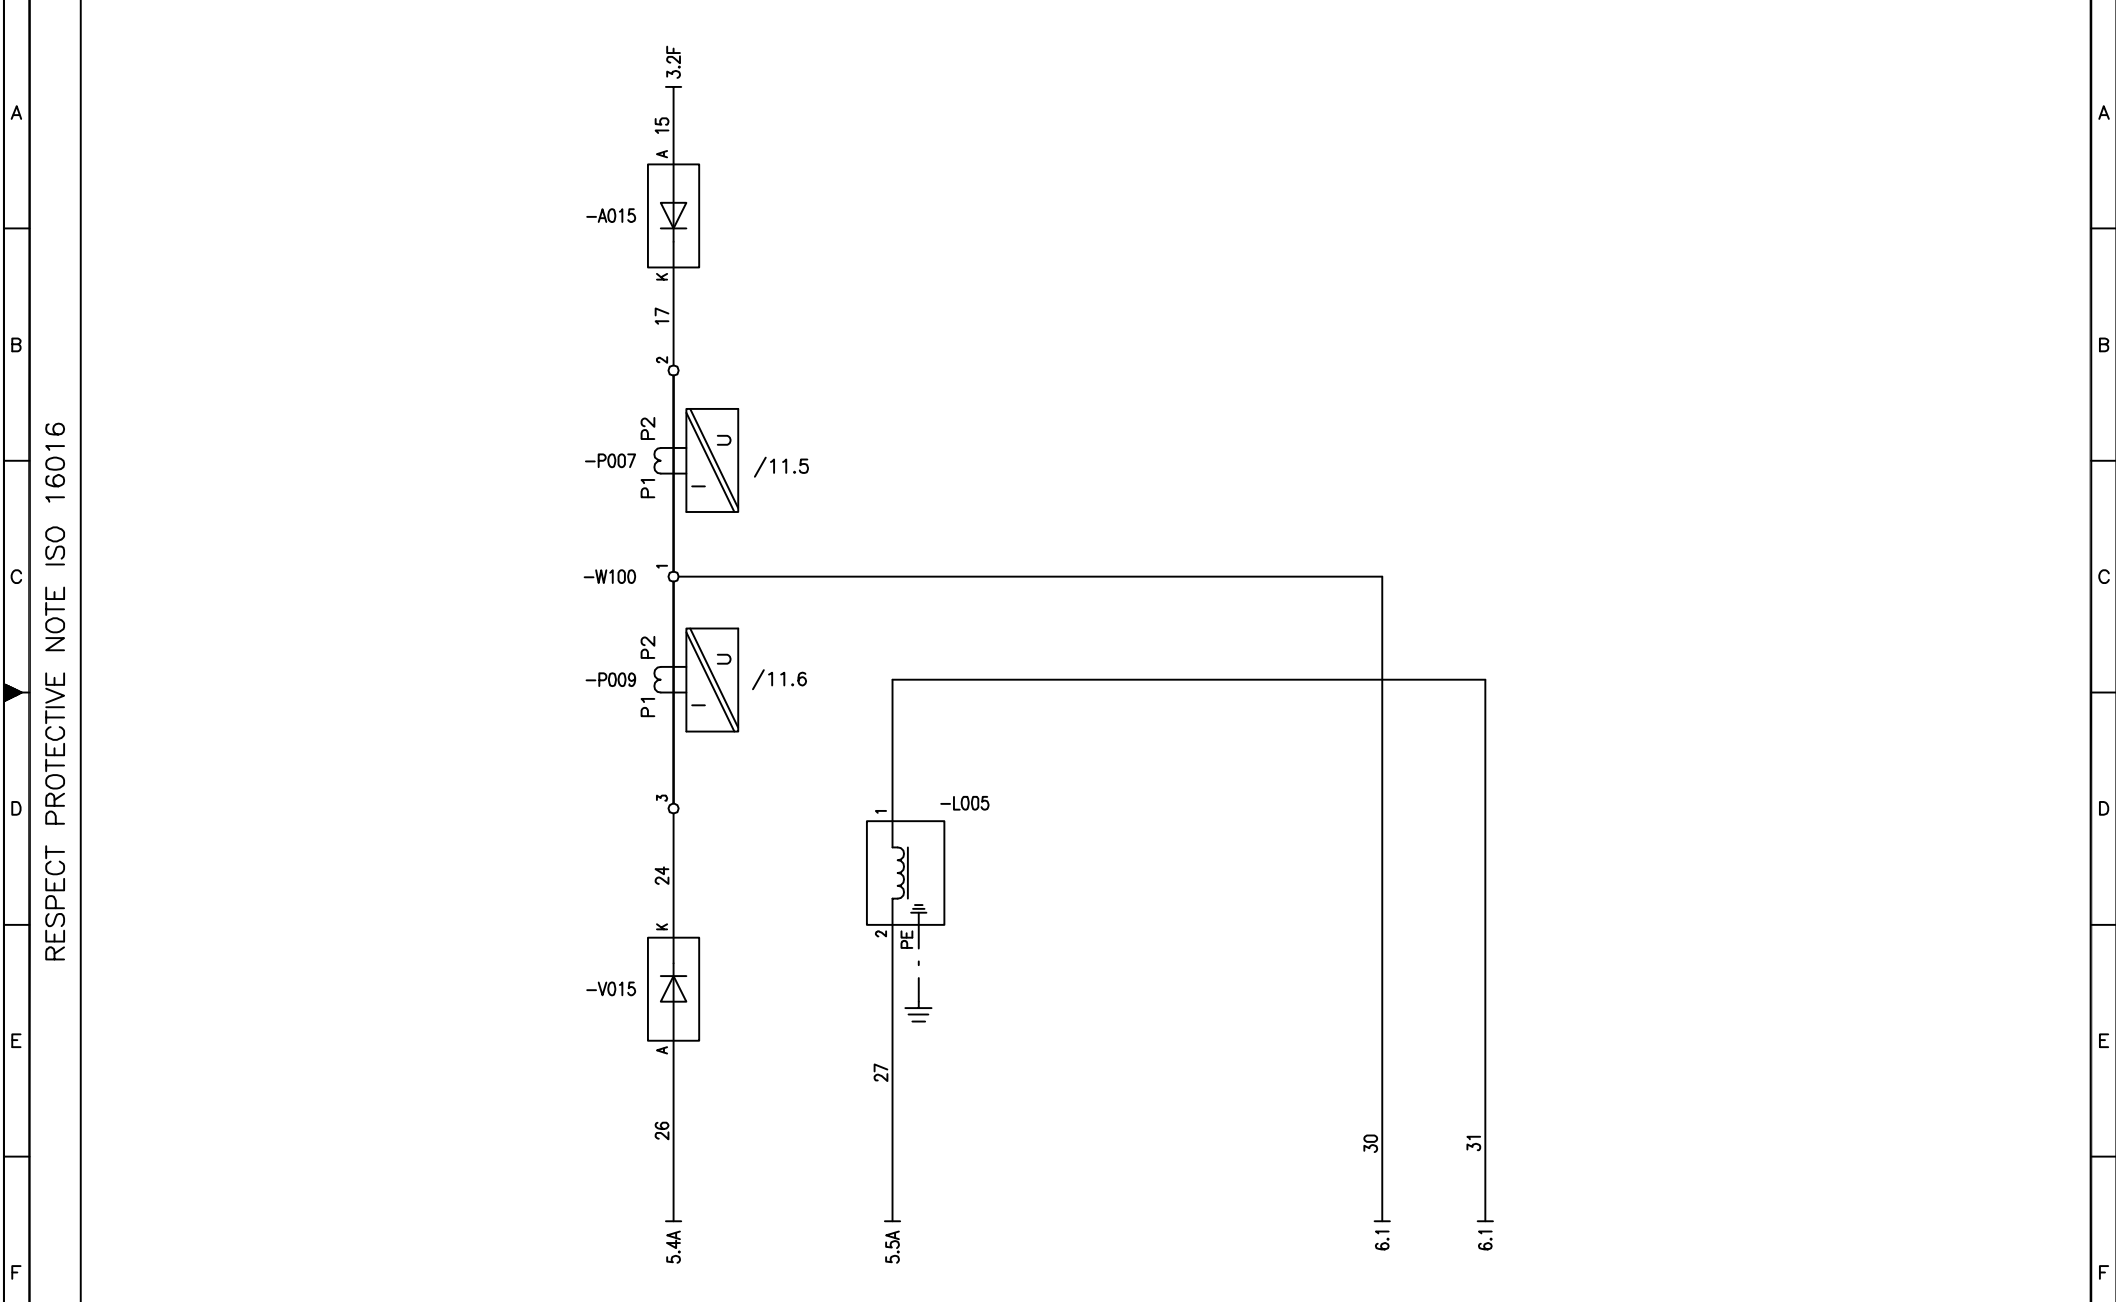

		DATE	09.08.10	GUTOR <small>by Schneider Electric</small>		TYPE : PEW 1060-220/220-EN		AS BUILT	
		DRAWN	WWA			WIRING DIAGRAM			
1	15.11.10	NAME	WWA	SUBST. FOR :				INT. CNT. :	
REV.	DESCRIPTION	DATE	CHECK			CHAPTER PAGE			

RESPECT PROTECTIVE NOTE ISO 16016

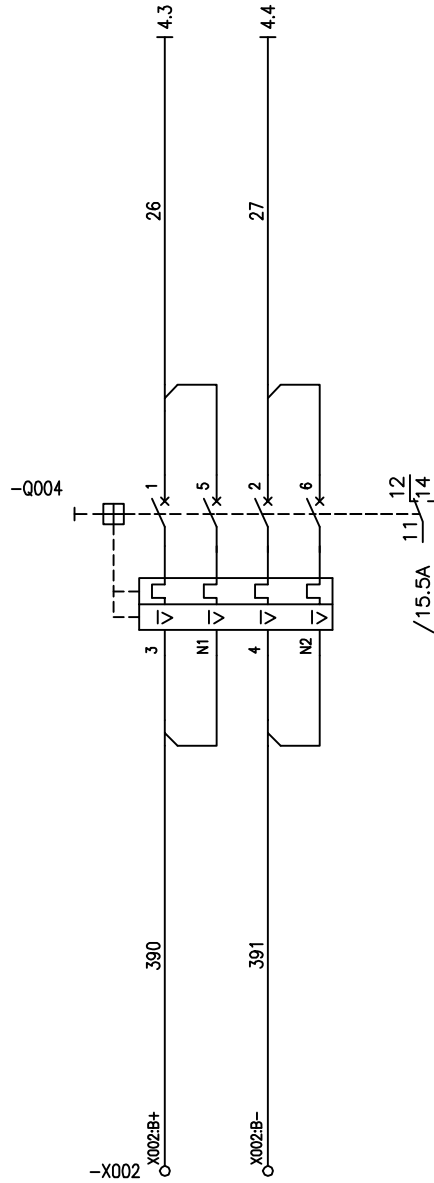

			DATE	09.08.10
			DRAWN	WWA
1		15.11.10	DATE	15.11.10
REV.	DESCRIPTION	DATE	NAME	CHECK
			HLU	


SUBST. FOR : INT. CNT. :



TYPE : PEW 1060-220/220-EN
 WIRING DIAGRAM
 UPS

AS BUILT
 DOC. NO. 1100322002/00

CHAPTER PAGE
 05 5 / 23

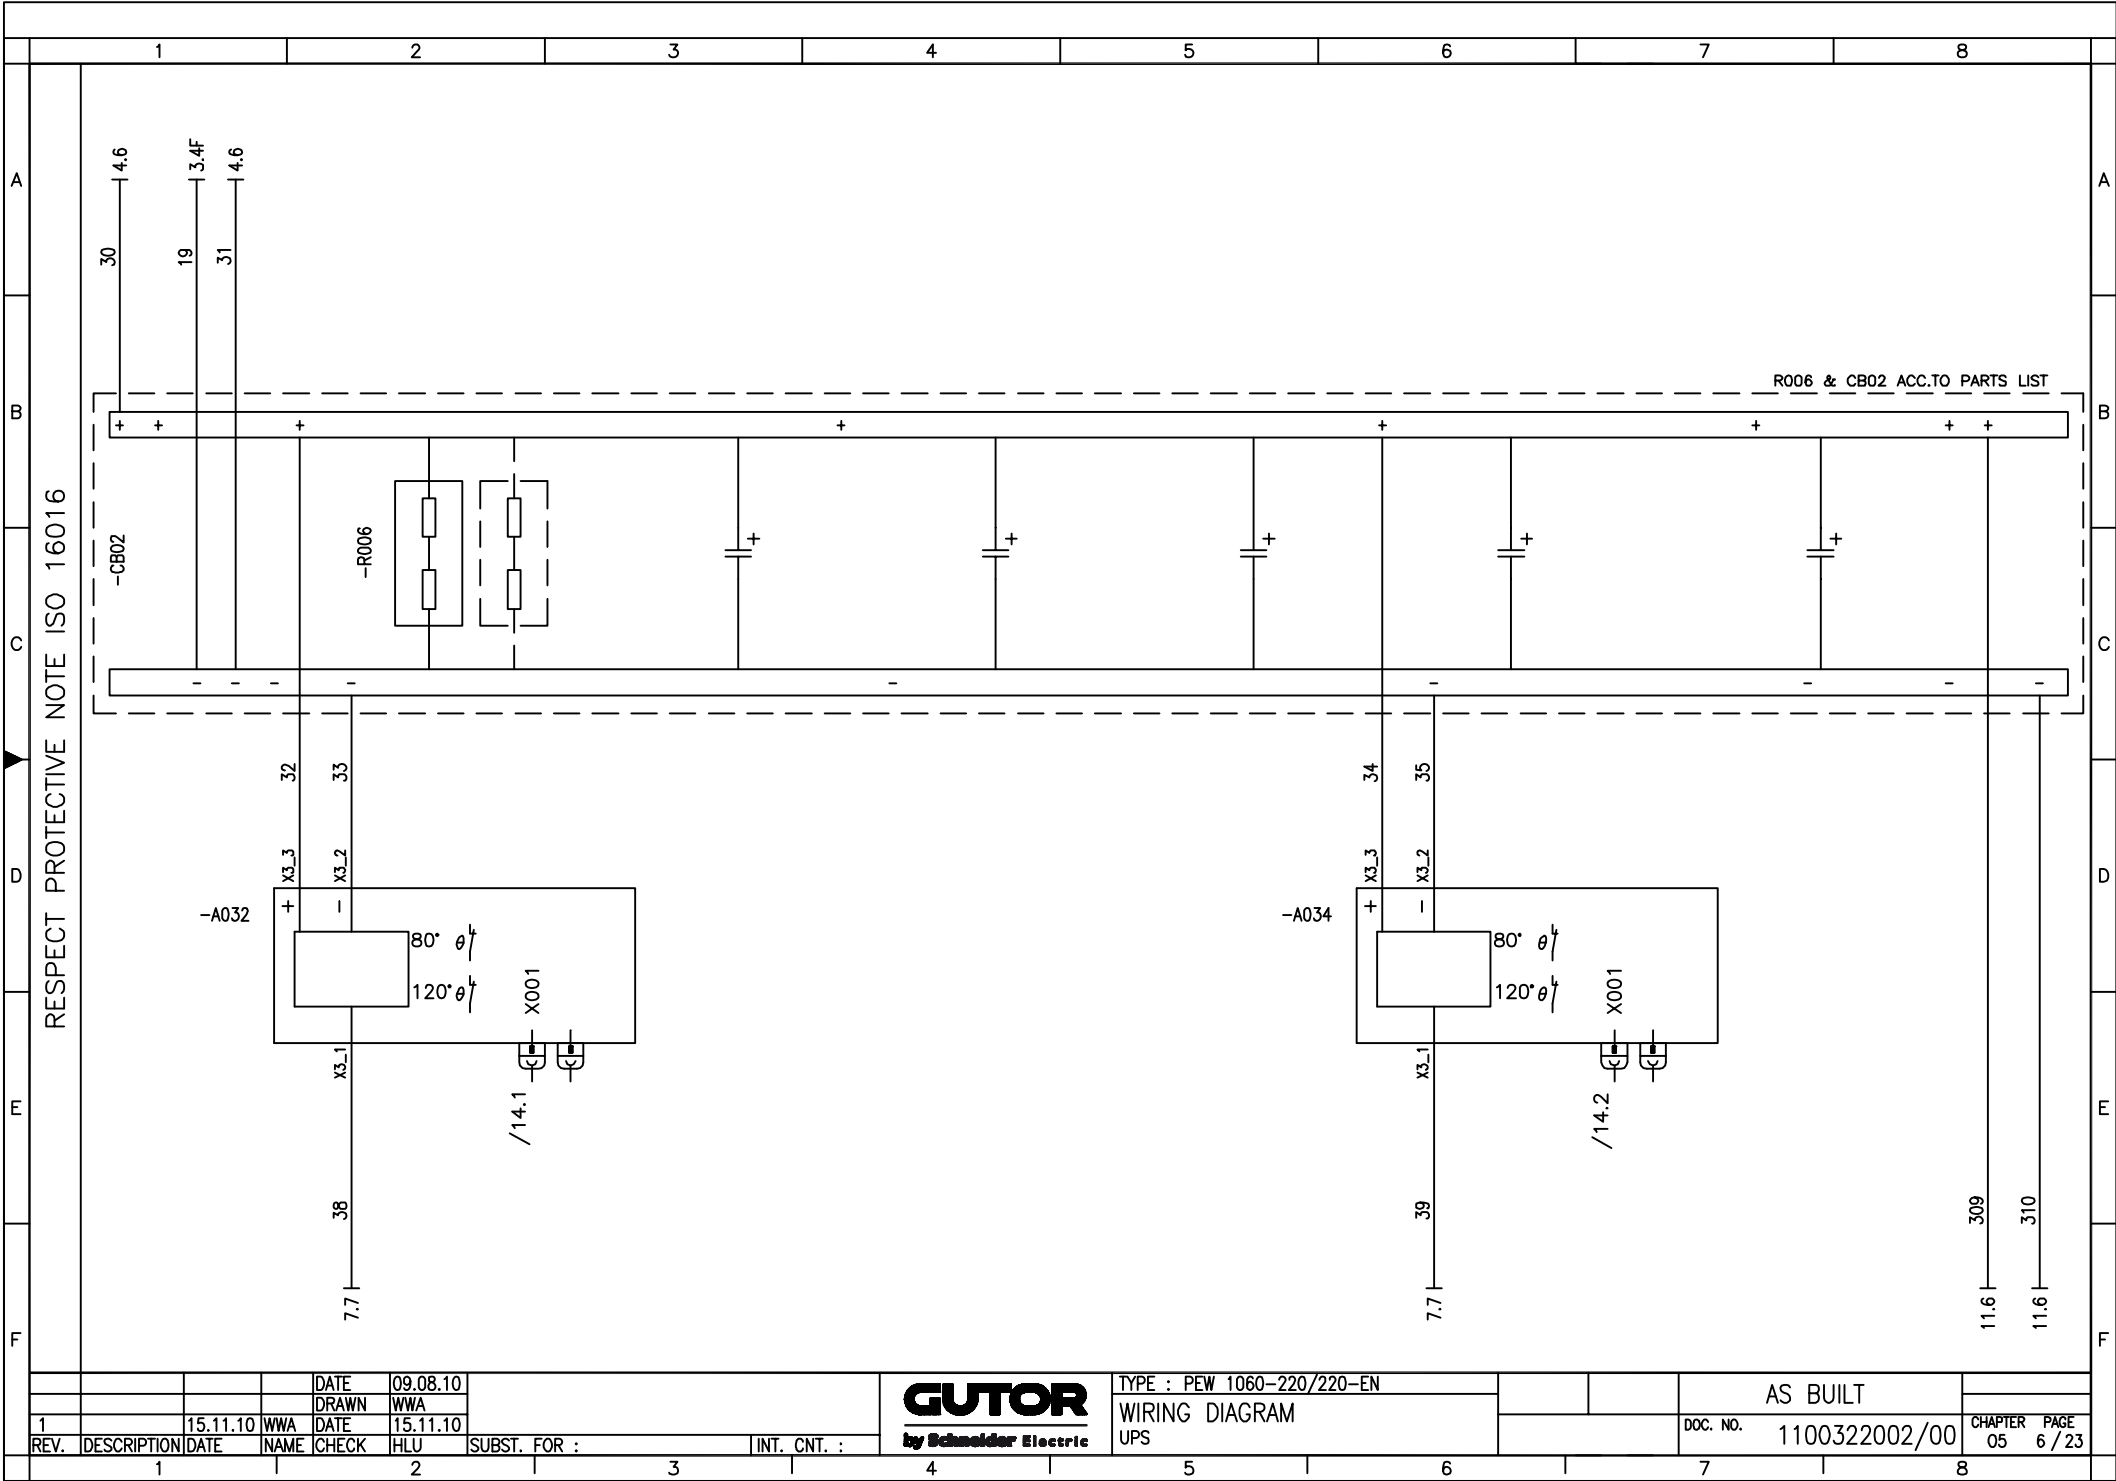

RESPECT PROTECTIVE NOTE ISO 16016

DATE	09.08.10
DRAWN	WWA
DATE	15.11.10
NAME	WWA
CHECK	HLU




TYPE : PEW 1060-220/220-EN
WIRING DIAGRAM
UPS

AS BUILT
DOC. NO. 1100322002/00

CHAPTER PAGE
05 6 / 23

REV.	DESCRIPTION	DATE	NAME	CHECK	HLU	SUBST. FOR :	INT. CNT. :
1		15.11.10	WWA				

RESPECT PROTECTIVE NOTE ISO 16016

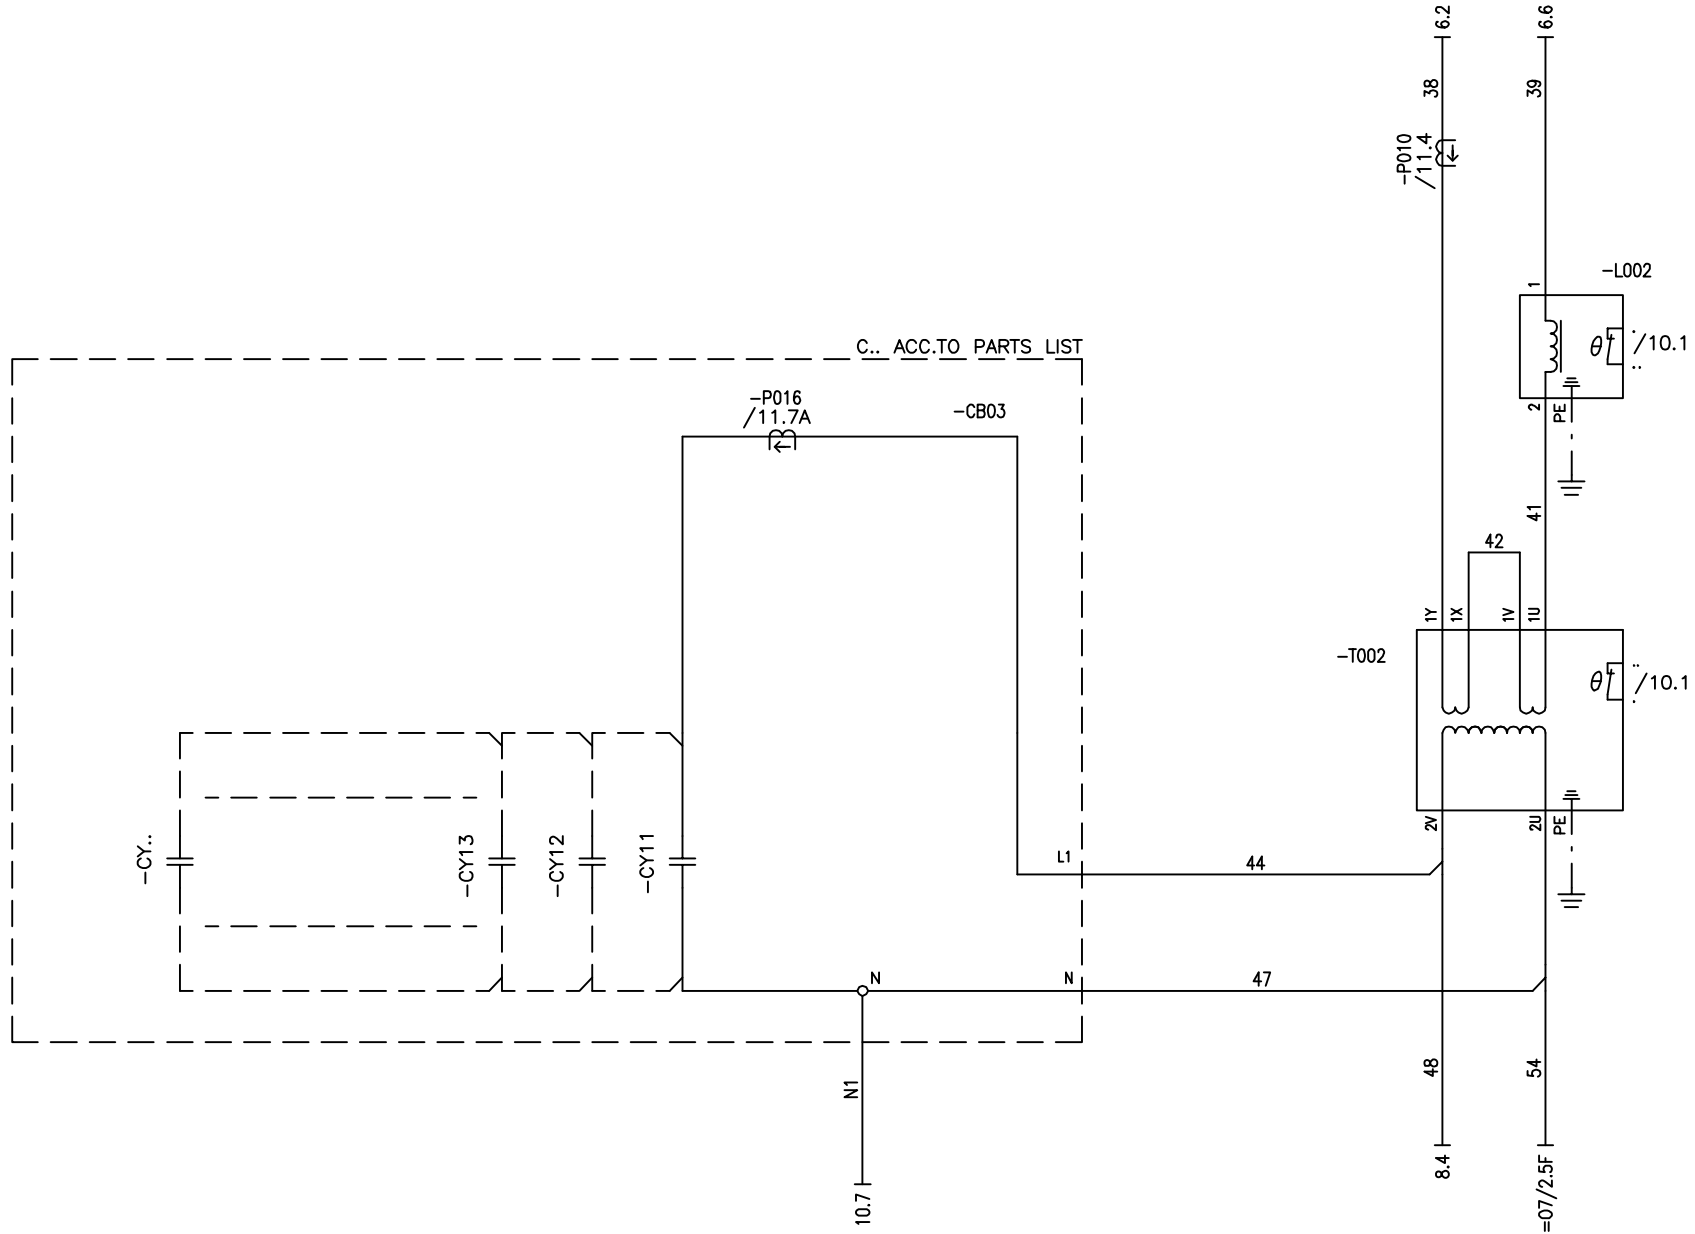

		DATE	09.08.10
		DRAWN	WWA
1	15.11.10	DATE	15.11.10
REV.	DESCRIPTION	DATE	NAME
			HLU

SUBST. FOR : INT. CNT. :




TYPE : PEW 1060-220/220-EN
 WIRING DIAGRAM
 UPS

AS BUILT
 DOC. NO. 1100322002/00

CHAPTER PAGE
 05 7/23

RESPECT PROTECTIVE NOTE ISO 16016

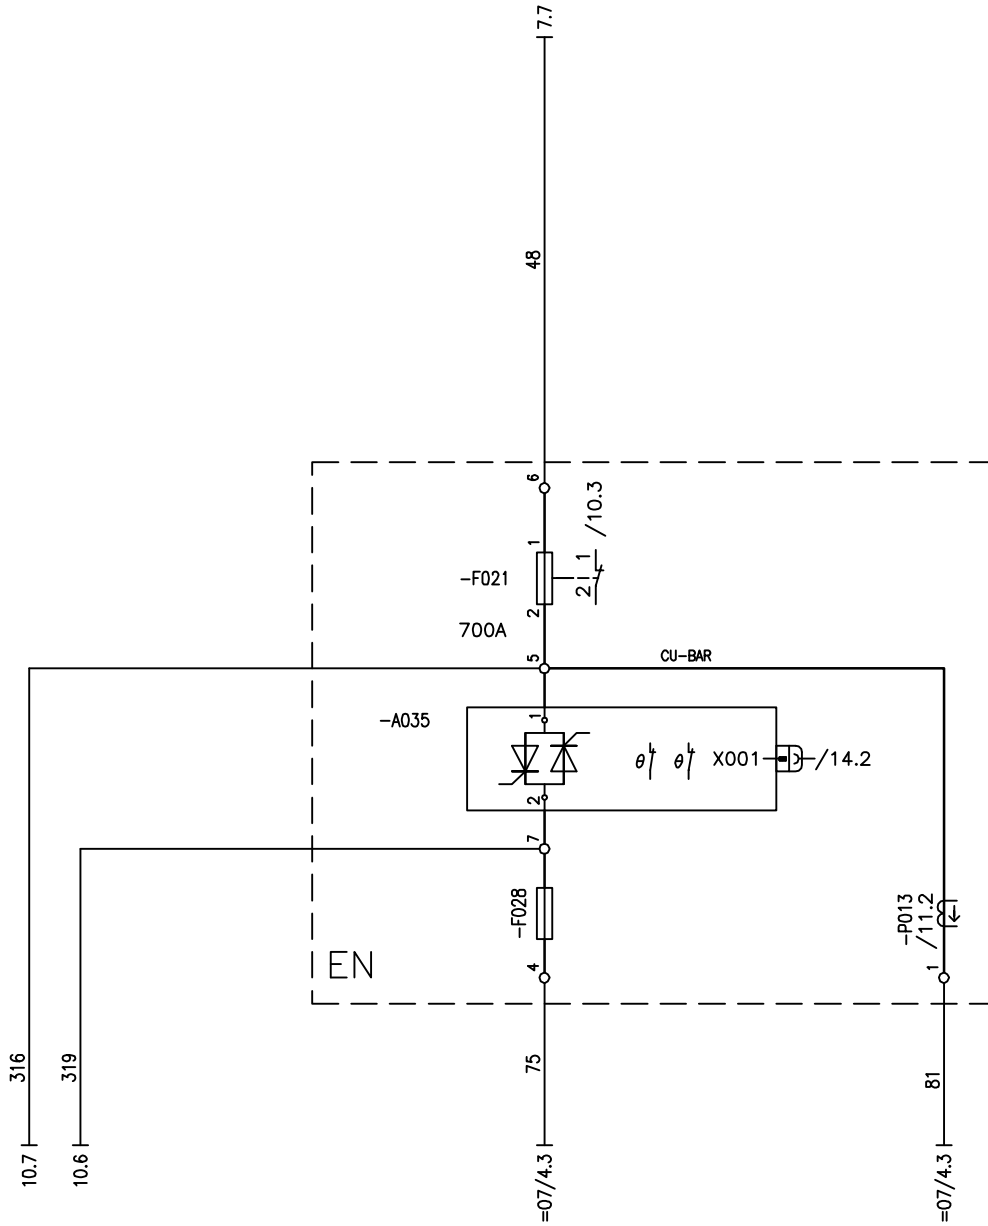

REV.	DESCRIPTION	DATE	NAME	CHECK	HLU	SUBST. FOR :	INT. CNT. :
		DATE	09.08.10				
		DRAWN	WWA				
1		15.11.10	WWA	DATE	15.11.10		




TYPE : PEW 1060-220/220-EN
WIRING DIAGRAM
UPS

AS BUILT
DOC. NO. 1100322002/00

CHAPTER PAGE
05 8 / 23

RESPECT PROTECTIVE NOTE ISO 16016

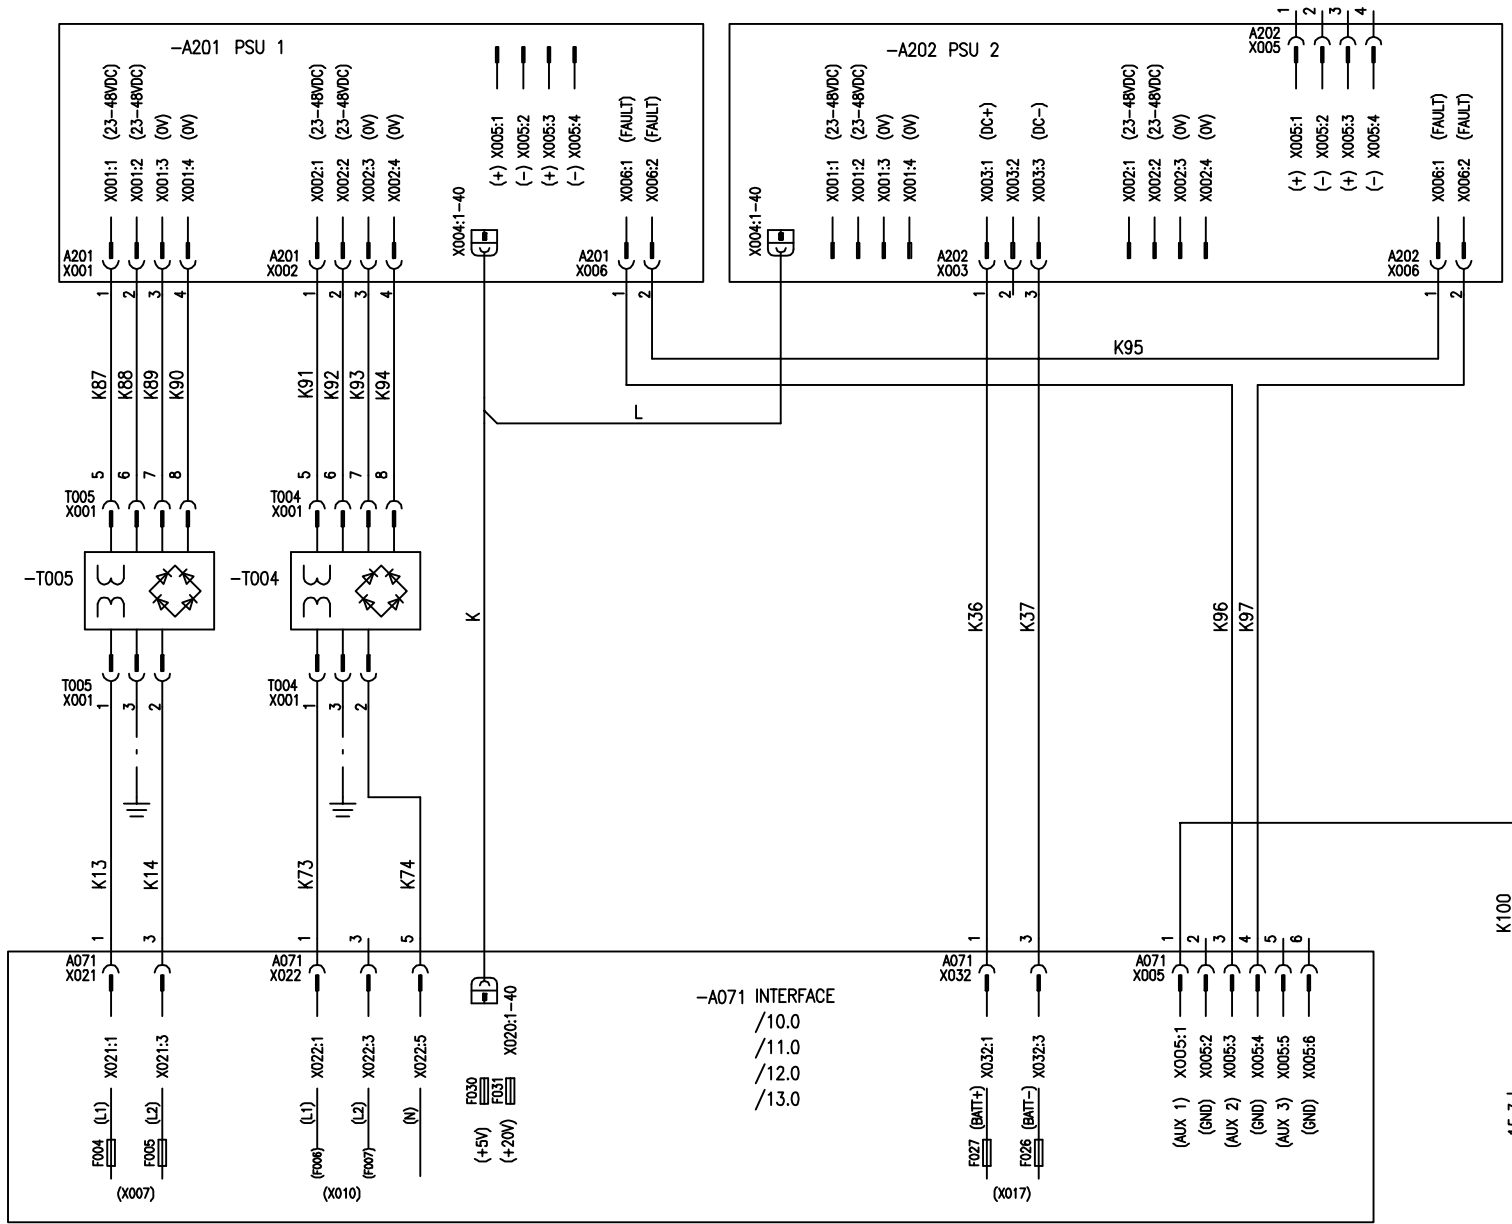

DATE	09.08.10
DRAWN	WWA
DATE	15.11.10
REV. 1	15.11.10 WWA
DESCRIPTION	NAME
CHECK	HLU


DATE: 09.08.10
 DRAWN: WWA
 DATE: 15.11.10
 REV. 1: 15.11.10 WWA
 DESCRIPTION: NAME
 CHECK: HLU
 SUBST. FOR :
 INT. CNT. :



TYPE : PEW 1060-220/220-EN
 WIRING DIAGRAM
 UPS

AS BUILT
 DOC. NO. 1100322002/00

RESPECT PROTECTIVE NOTE ISO 16016

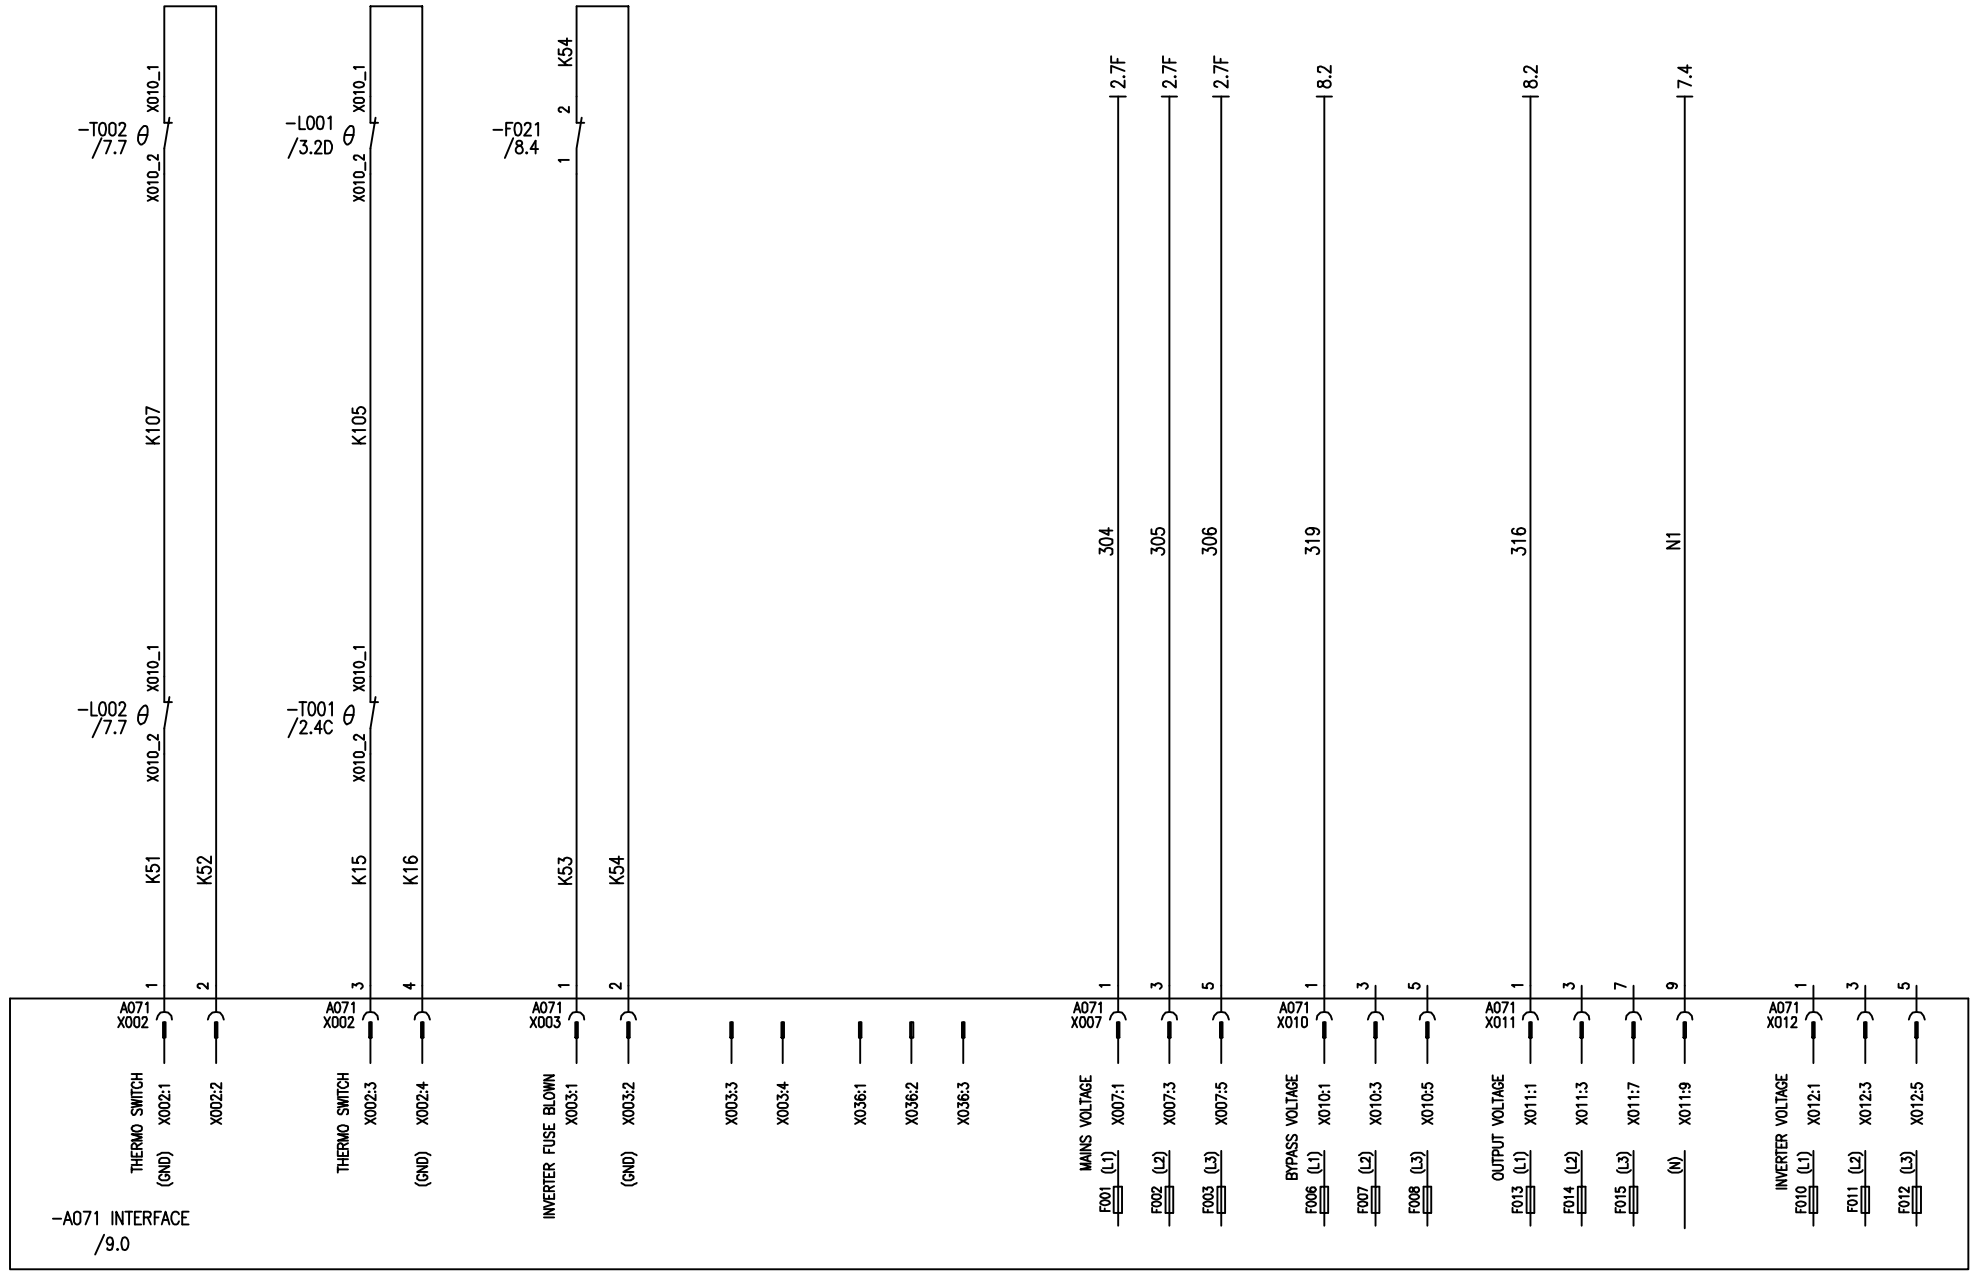

DATE	09.08.10
DRAWN	WWA
DATE	15.11.10
NAME	WWA
CHECK	HLU
REV.	1
DESCRIPTION	


INT. CNT. : SUBST. FOR :



TYPE : PEW 1060-220/220-EN
WIRING DIAGRAM
UPS

AS BUILT
DOC. NO. 1100322002/00
CHAPTER PAGE 05 10 / 23

RESPECT PROTECTIVE NOTE ISO 16016

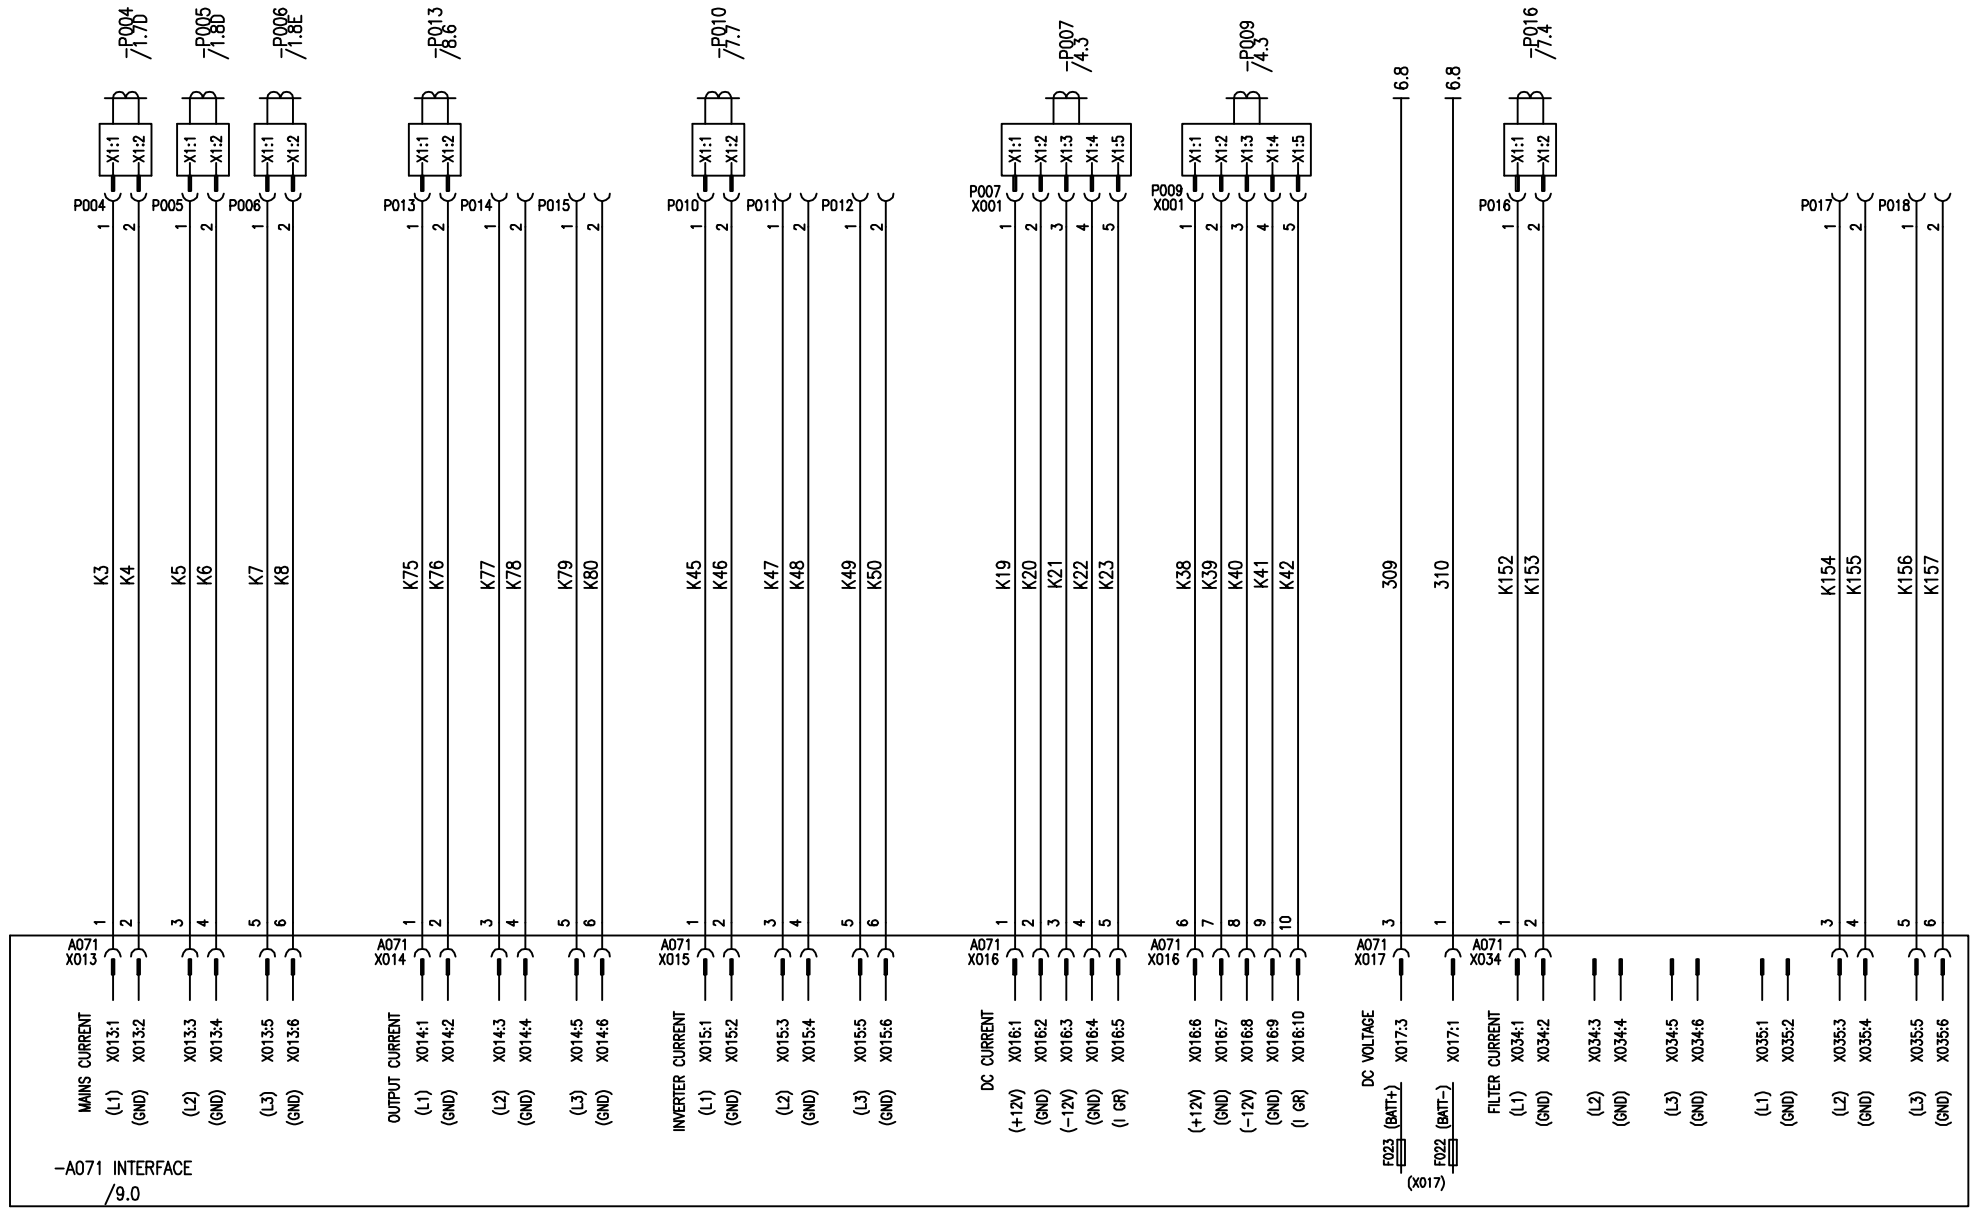


DATE	09.08.10
DRAWN	WWA
DATE	15.11.10
REV.	DESCRIPTION
1	15.11.10 WWA
NAME	CHECK
HLU	INT. CNT. :



TYPE : PEW 1060-220/220-EN
 WIRING DIAGRAM
 UPS

AS BUILT
 DOC. NO. 1100322002/00

RESPECT PROTECTIVE NOTE ISO 16016

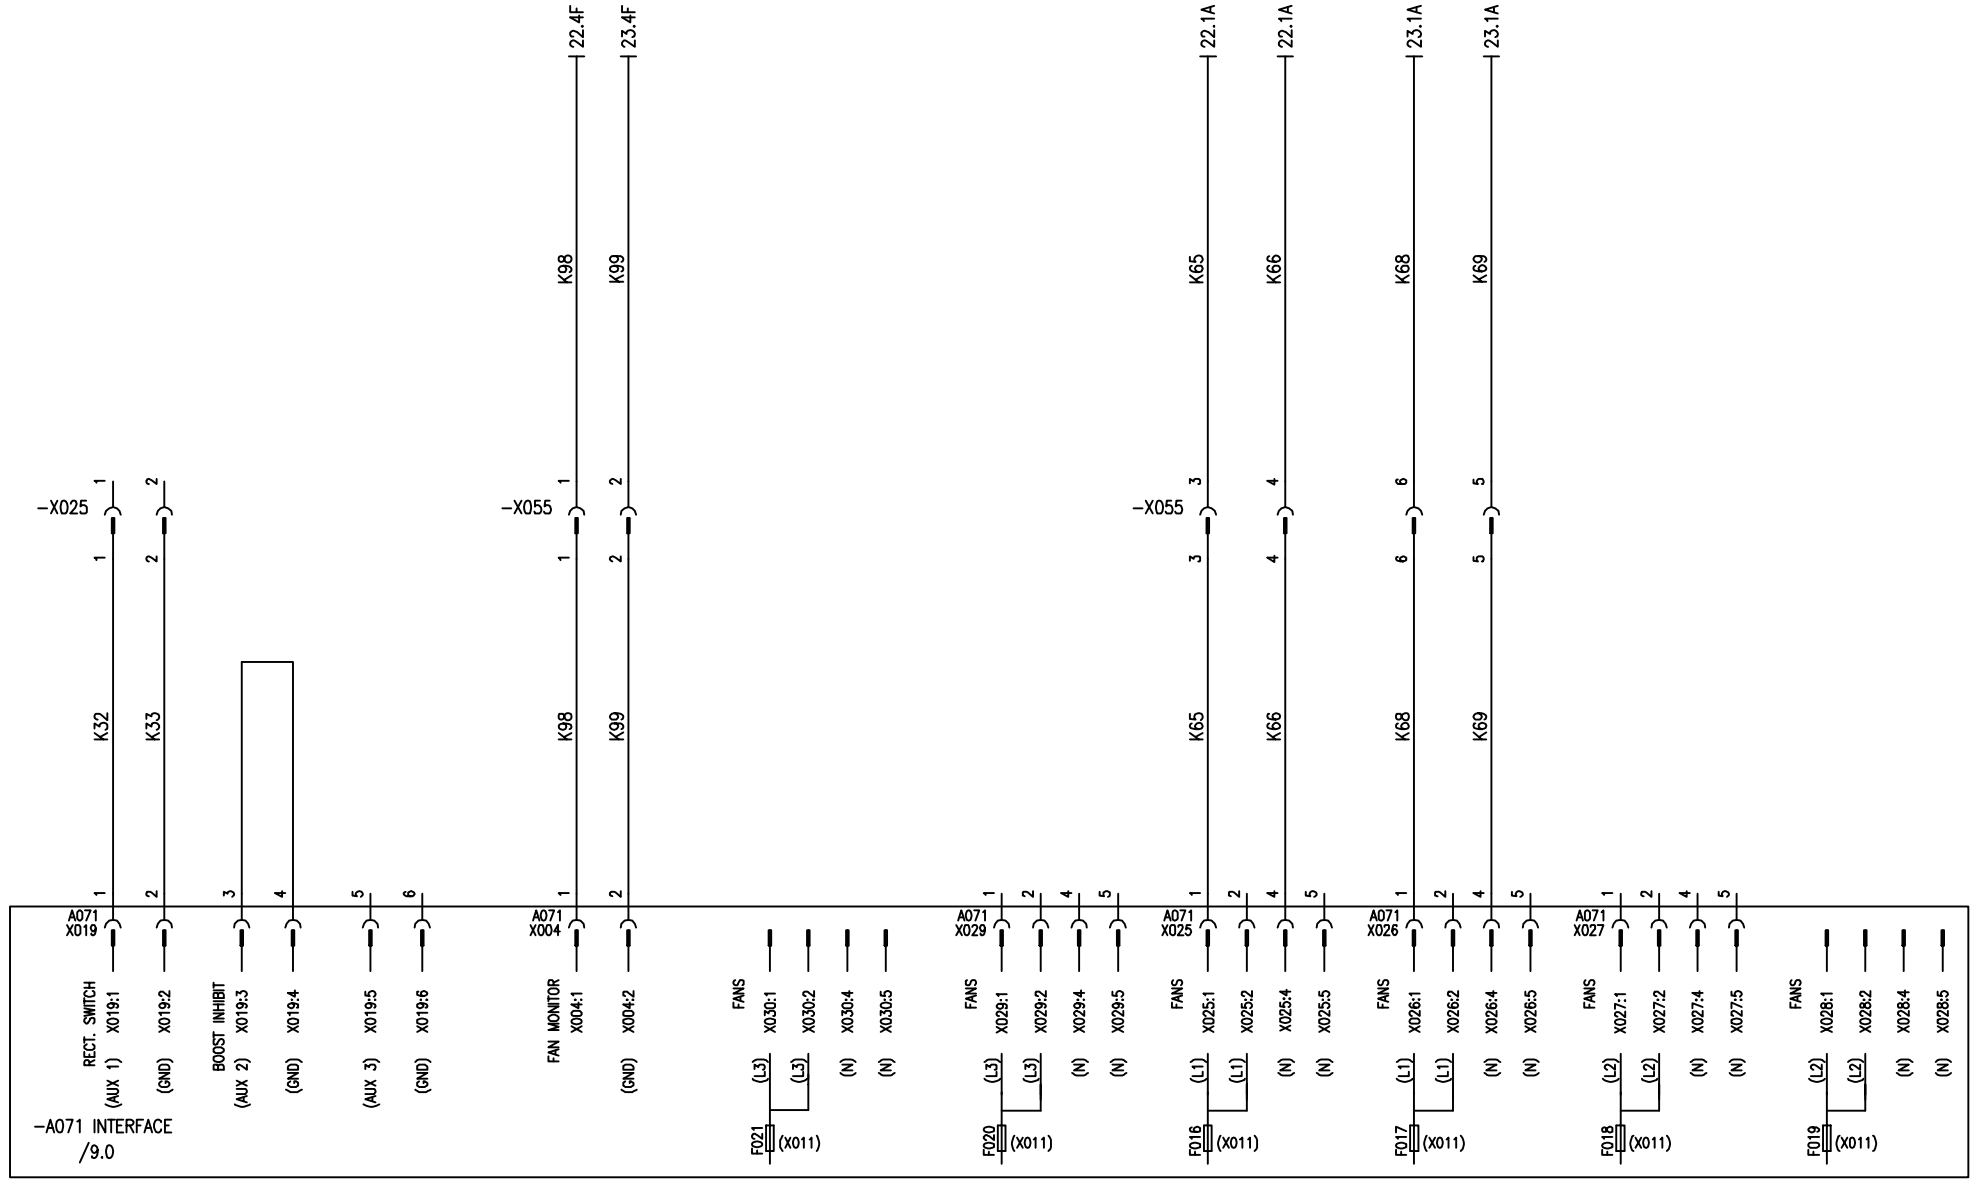


DATE	09.08.10
DRAWN	WWA
DATE	15.11.10
CHECK	HLU



TYPE : PEW 1060-220/220-EN
 WIRING DIAGRAM
 UPS

AS BUILT
 DOC. NO. 1100322002/00

RESPECT PROTECTIVE NOTE ISO 16016

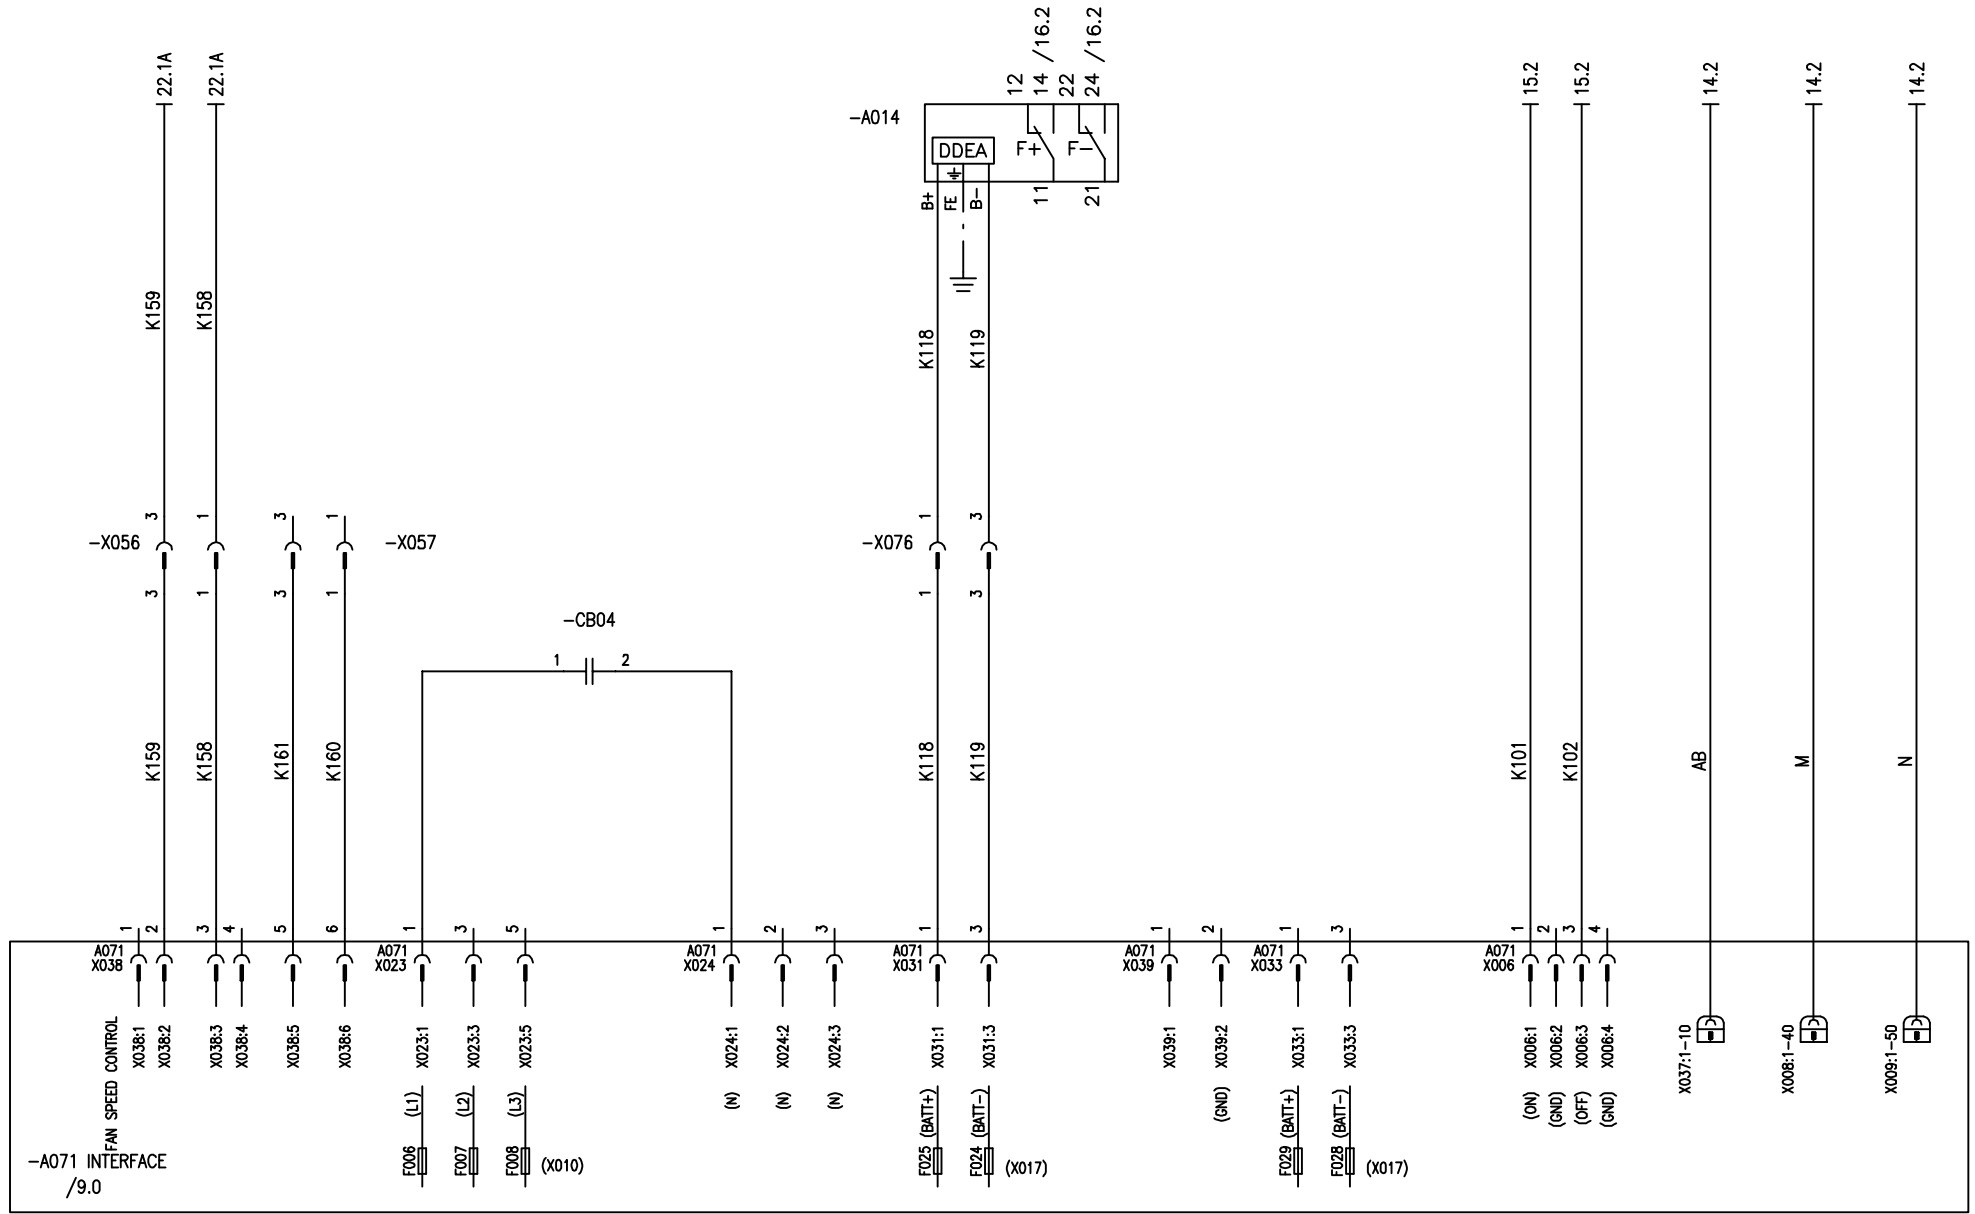


DATE	09.08.10
DRAWN	WWA
DATE	15.11.10
NAME	WWA
CHECK	HLU
SUBST. FOR :	
INT. CNT. :	



TYPE : PEW 1060-220/220-EN
WIRING DIAGRAM
UPS

AS BUILT
DOC. NO. 1100322002/00

RESPECT PROTECTIVE NOTE ISO 16016

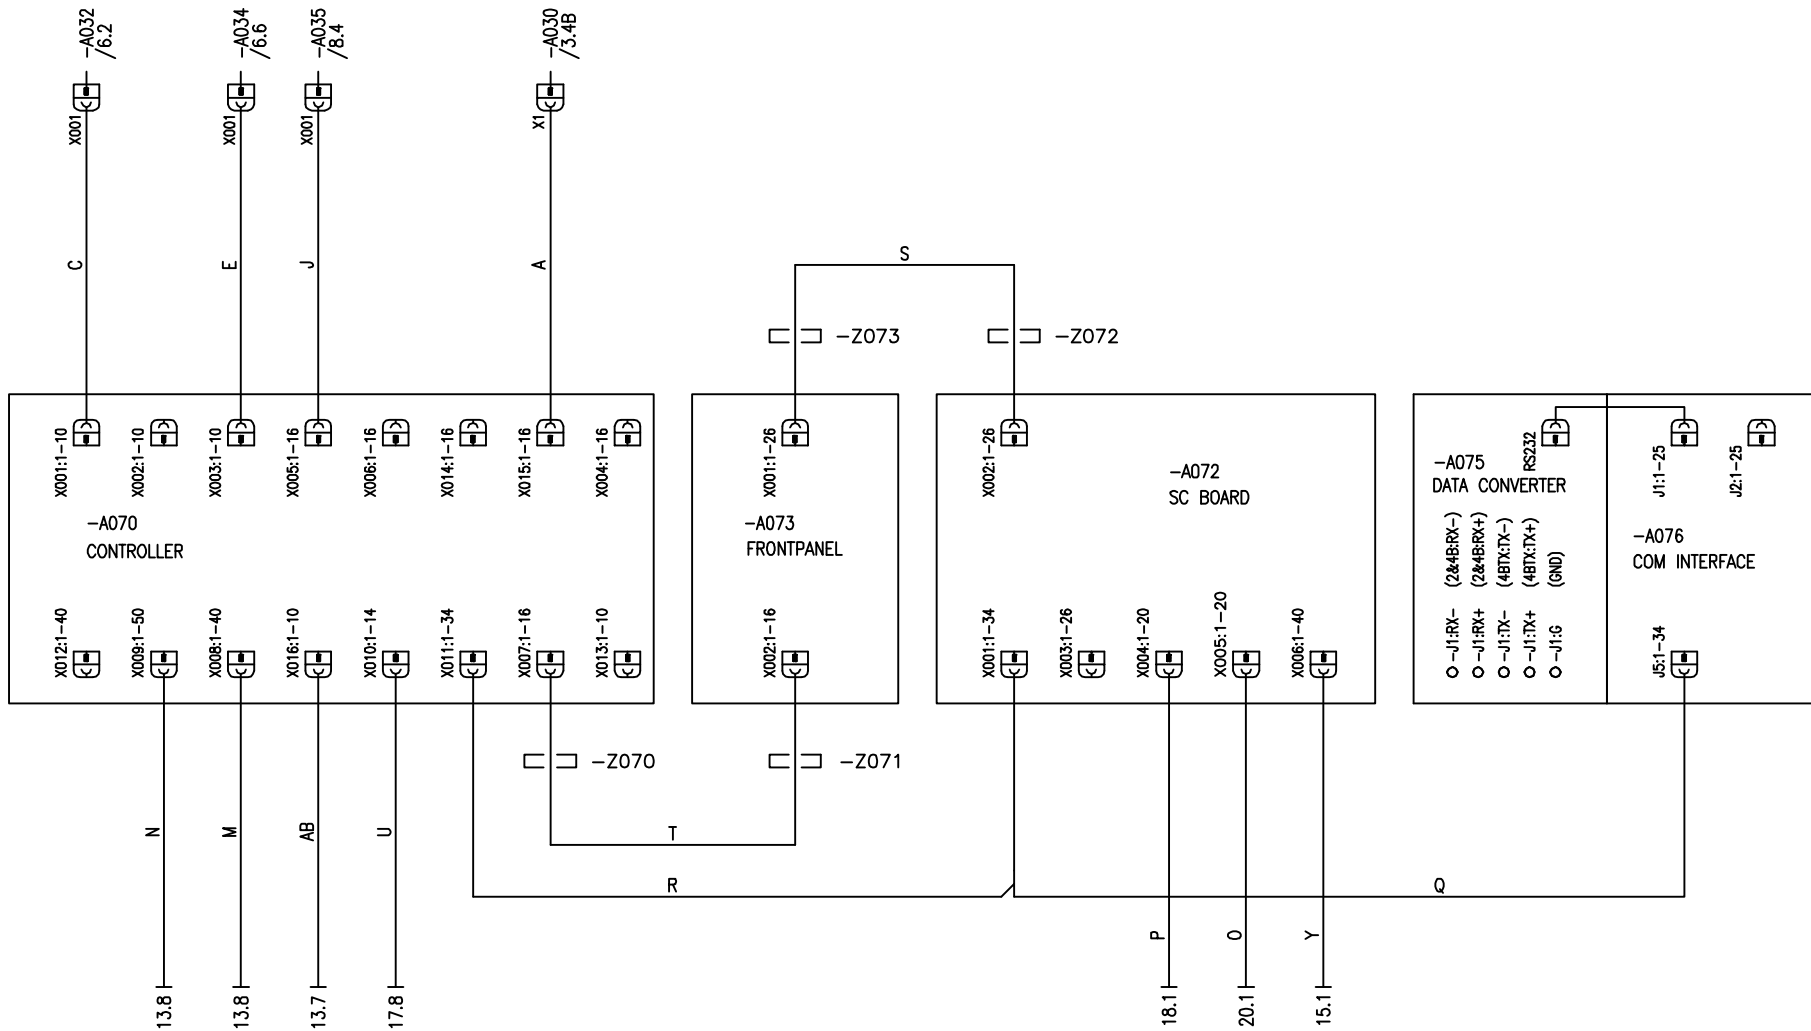

DATE	09.08.10
DRAWN	WWA
DATE	15.11.10
NAME	WWA
CHECK	HLU
REV.	1
DESCRIPTION	


INT. CNT. : SUBST. FOR :



TYPE : PEW 1060-220/220-EN
 WIRING DIAGRAM
 UPS

AS BUILT
 DOC. NO. 1100322002/00

RESPECT PROTECTIVE NOTE ISO 16016

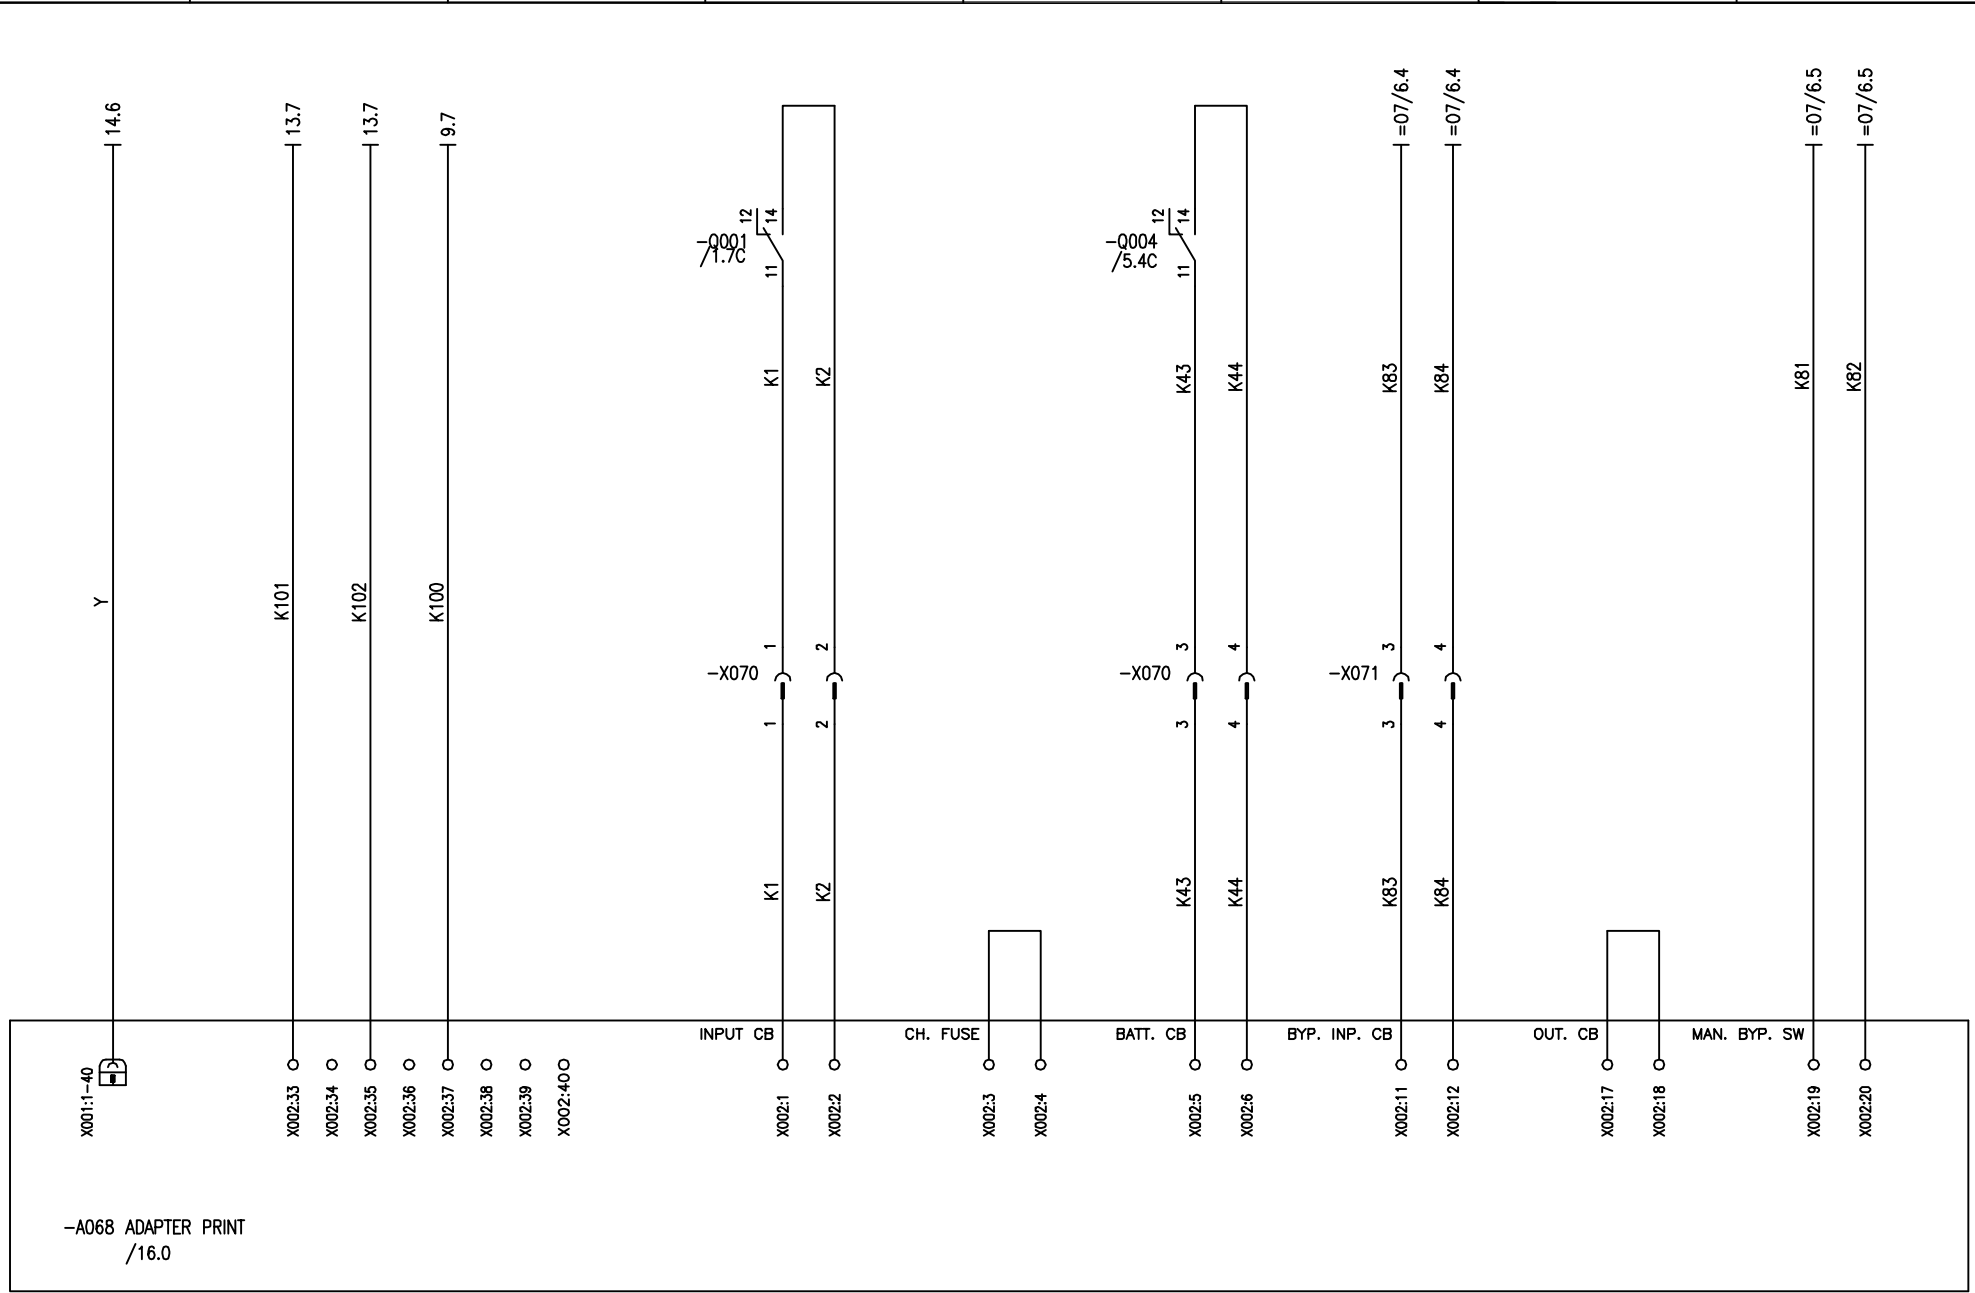

-A068 ADAPTER PRINT
/16.0

		DATE	09.08.10
		DRAWN	WWA
1	15.11.10	DATE	15.11.10
REV.	DESCRIPTION	DATE	NAME
			CHECK
			HLU

SUBST. FOR : INT. CNT. :



TYPE : PEW 1060-220/220-EN
WIRING DIAGRAM
UPS

AS BUILT
DOC. NO. 1100322002/00

CHAPTER PAGE
05 15 / 23

1 2 3 4 5 6 7 8

A

B

C

D

E

F

A

B


C

D

E

F

RESPECT PROTECTIVE NOTE ISO 16016

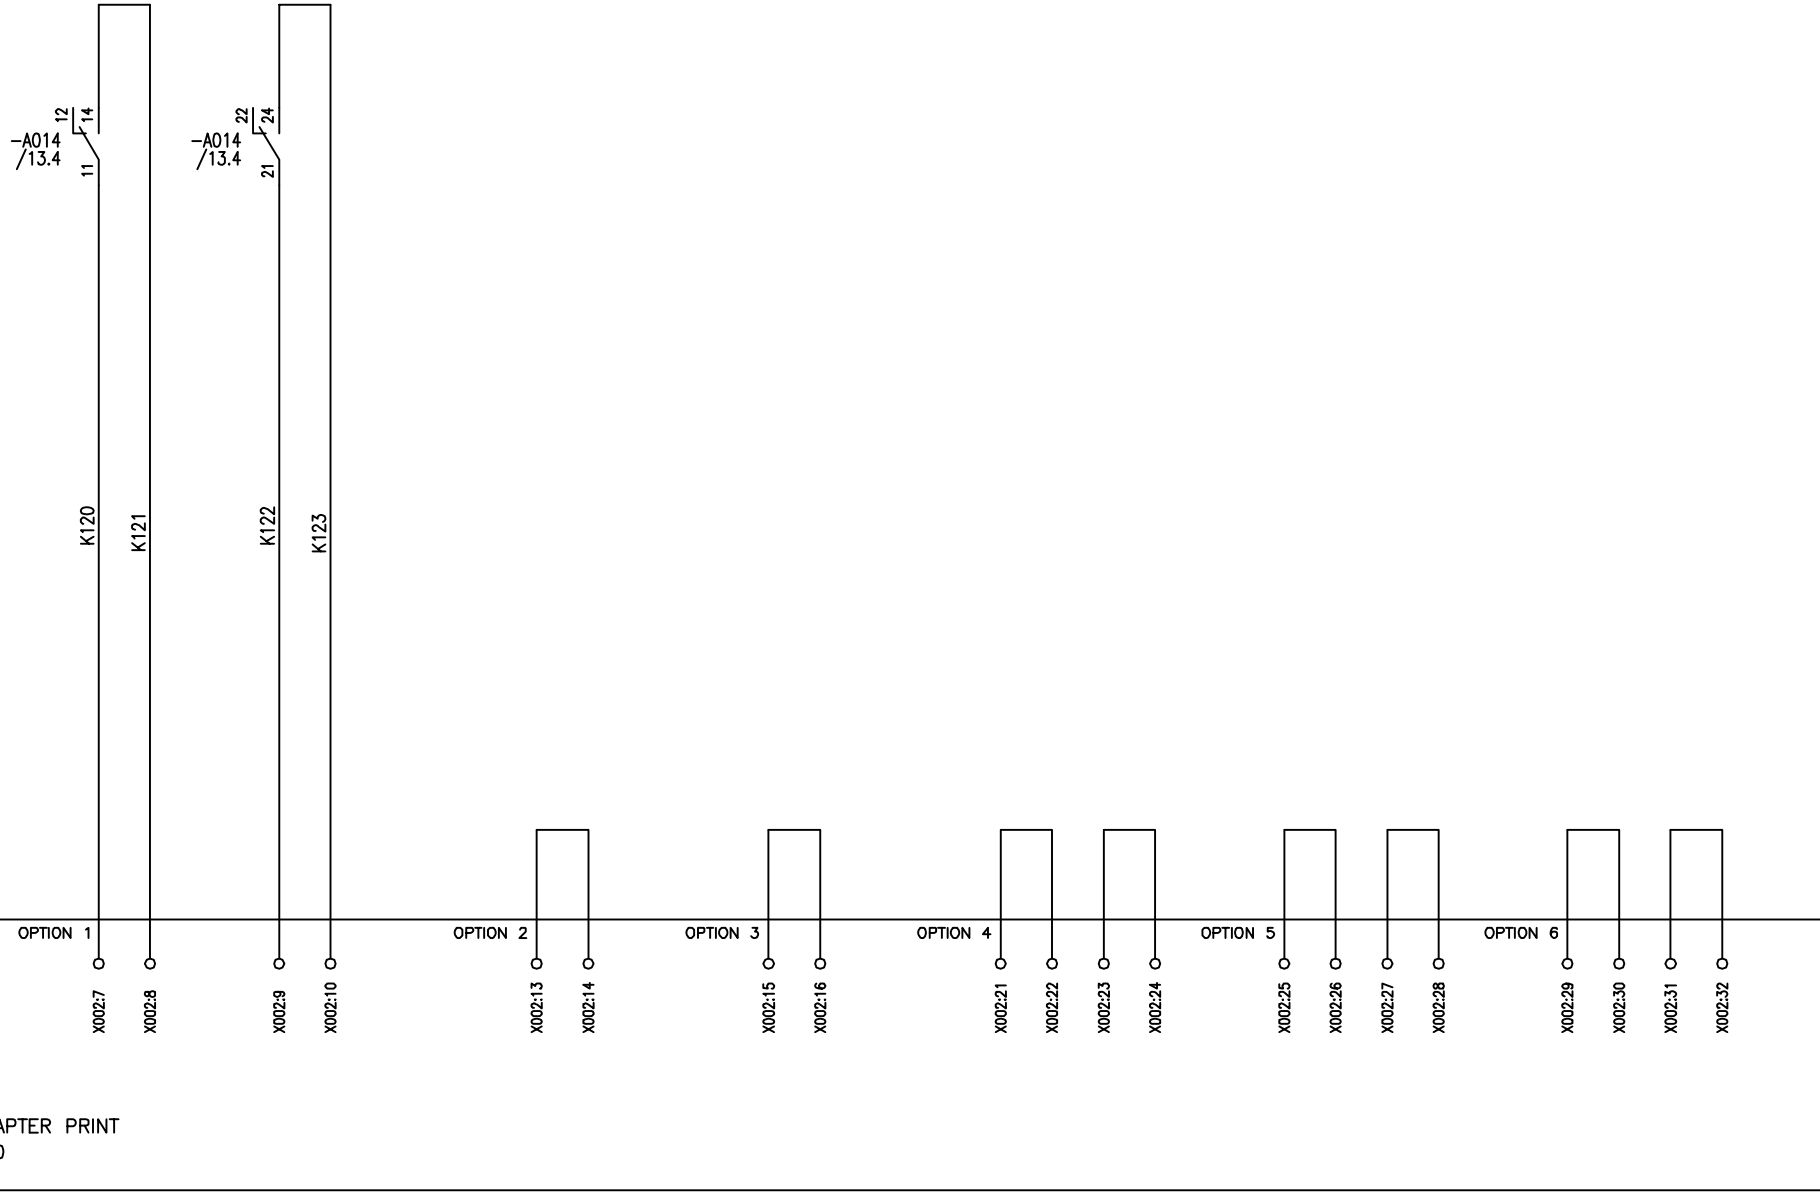

			DATE	09.08.10
			DRAWN	WWA
1		15.11.10	DATE	15.11.10
REV.	DESCRIPTION	DATE	NAME	CHECK
			HLU	

SUBST. FOR : INT. CNT. :




TYPE : PEW 1060-220/220-EN
WIRING DIAGRAM
UPS

AS BUILT
DOC. NO. 1100322002/00
CHAPTER PAGE 05 16 / 23

1 2 3 4 5 6 7 8

RESPECT PROTECTIVE NOTE ISO 16016

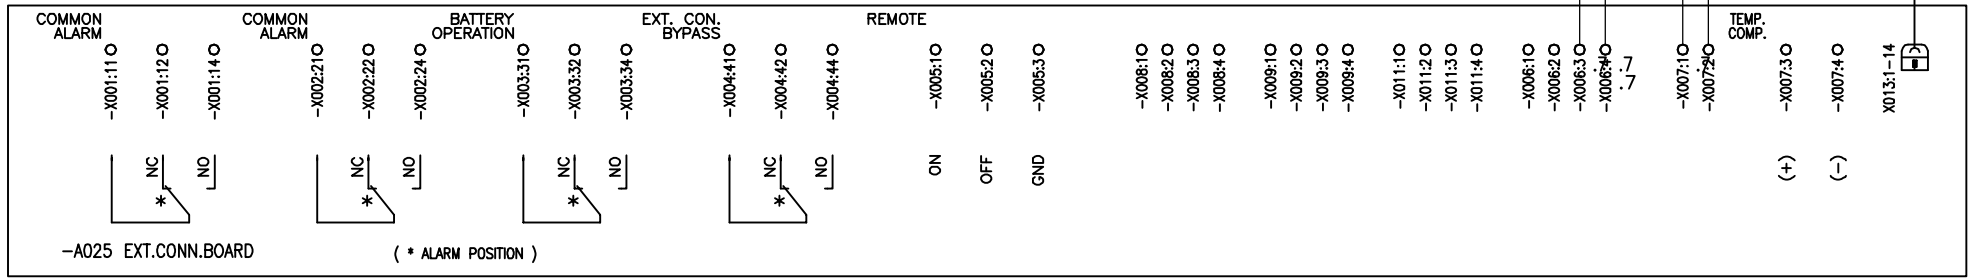

U 14.3

DATE	09.08.10
DRAWN	WWA
DATE	15.11.10
REV.	DESCRIPTION
1	15.11.10 WWA
DATE	15.11.10
REV.	DESCRIPTION
1	15.11.10 WWA




TYPE : PEW 1060-220/220-EN
 WIRING DIAGRAM
 UPS

AS BUILT
 DOC. NO. 1100322002/00

RESPECT PROTECTIVE NOTE ISO 16016

P 14.6

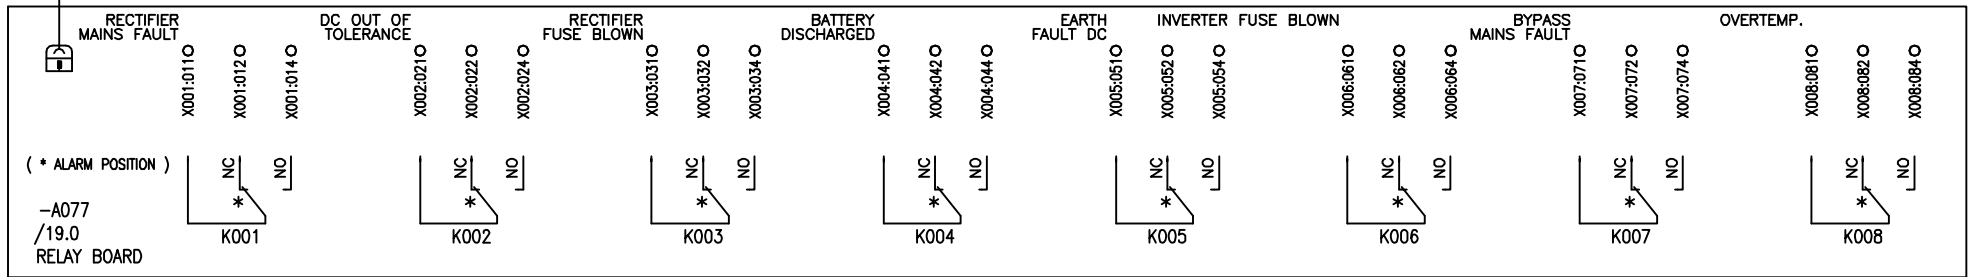

DATE	09.08.10
DRAWN	WWA
DATE	15.11.10
NAME	HLU



TYPE : PEW 1060-220/220-EN

WIRING DIAGRAM
UPS


AS BUILT

DOC. NO. 1100322002/00

CHAPTER PAGE
05 18 / 23

REV.	DESCRIPTION	DATE	CHECK	HLU	SUBST. FOR :	INT. CNT. :
1		15.11.10	WWA			

RESPECT PROTECTIVE NOTE ISO 16016

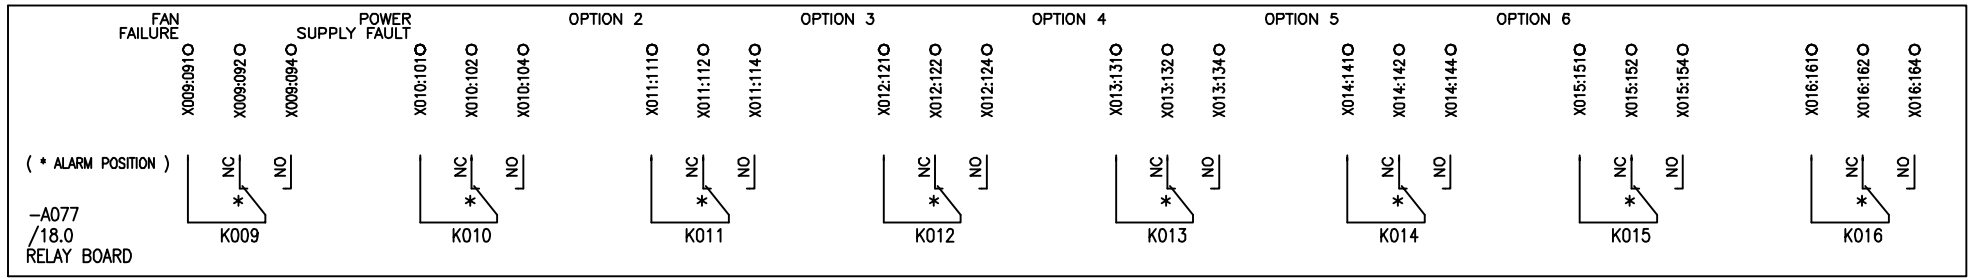

			DATE	09.08.10
			DRAWN	WWA
1		15.11.10	DATE	15.11.10
REV.	DESCRIPTION	DATE	NAME	CHECK
			HLU	SUBST. FOR :




TYPE : PEW 1060-220/220-EN
 WIRING DIAGRAM
 UPS

AS BUILT
 DOC. NO. 1100322002/00
 CHAPTER PAGE 05 19 / 23

RESPECT PROTECTIVE NOTE ISO 16016

14.6
0

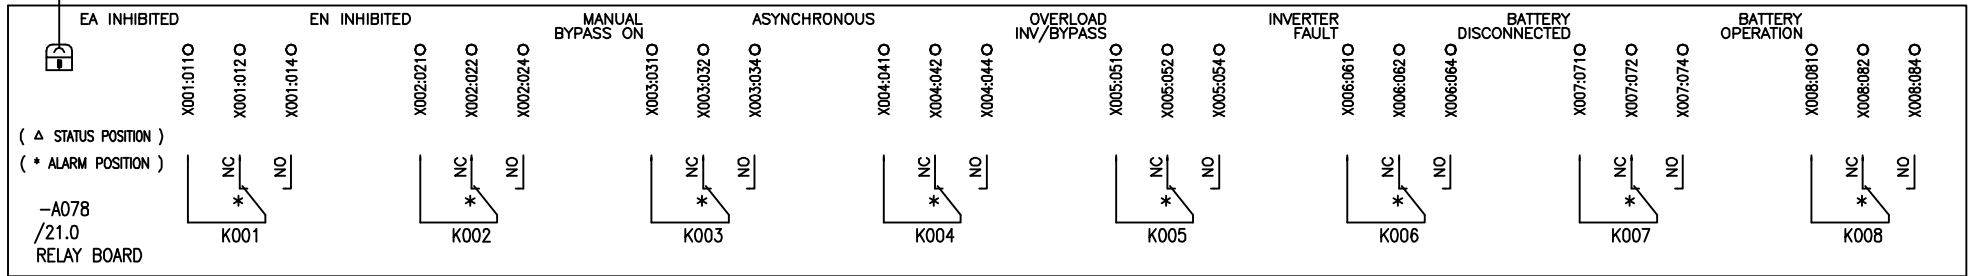

			DATE	09.08.10
			DRAWN	WWA
1	15.11.10	WWA	DATE	15.11.10
REV.	DESCRIPTION	DATE	NAME	CHECK
			HLU	SUBST. FOR :




TYPE : PEW 1060-220/220-EN
 WIRING DIAGRAM
 UPS

AS BUILT

DOC. NO. 1100322002/00 CHAPTER PAGE 05 20 / 23

RESPECT PROTECTIVE NOTE ISO 16016

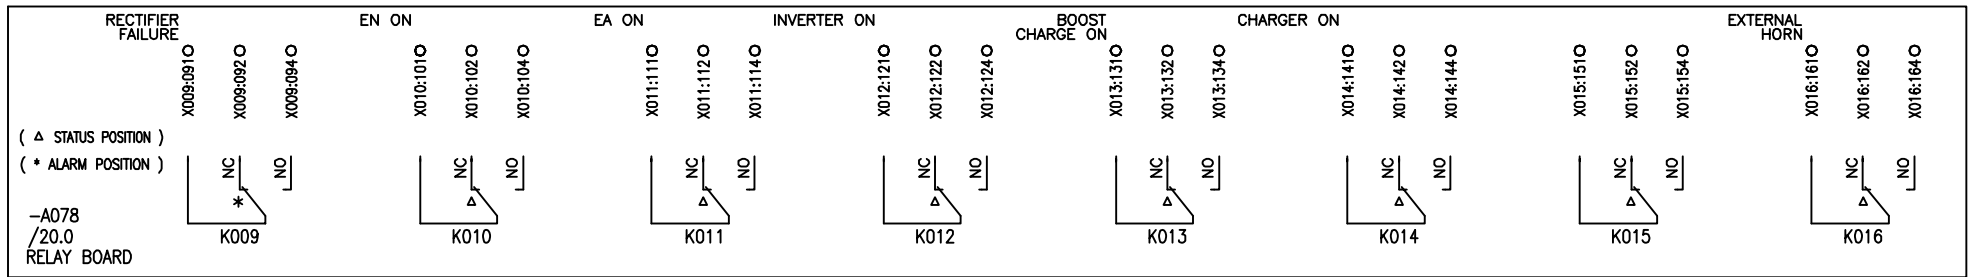

DATE	09.08.10
DRAWN	WWA
DATE	15.11.10
NAME	WWA
CHECK	
HLU	




TYPE : PEW 1060-220/220-EN
 WIRING DIAGRAM
 UPS

AS BUILT
 DOC. NO. 1100322002/00

CHAPTER PAGE
 05 21/23

REV.	DESCRIPTION	DATE	NAME	CHECK	HLU	SUBST. FOR :	INT. CNT. :
1		15.11.10	WWA				

RESPECT PROTECTIVE NOTE ISO 16016

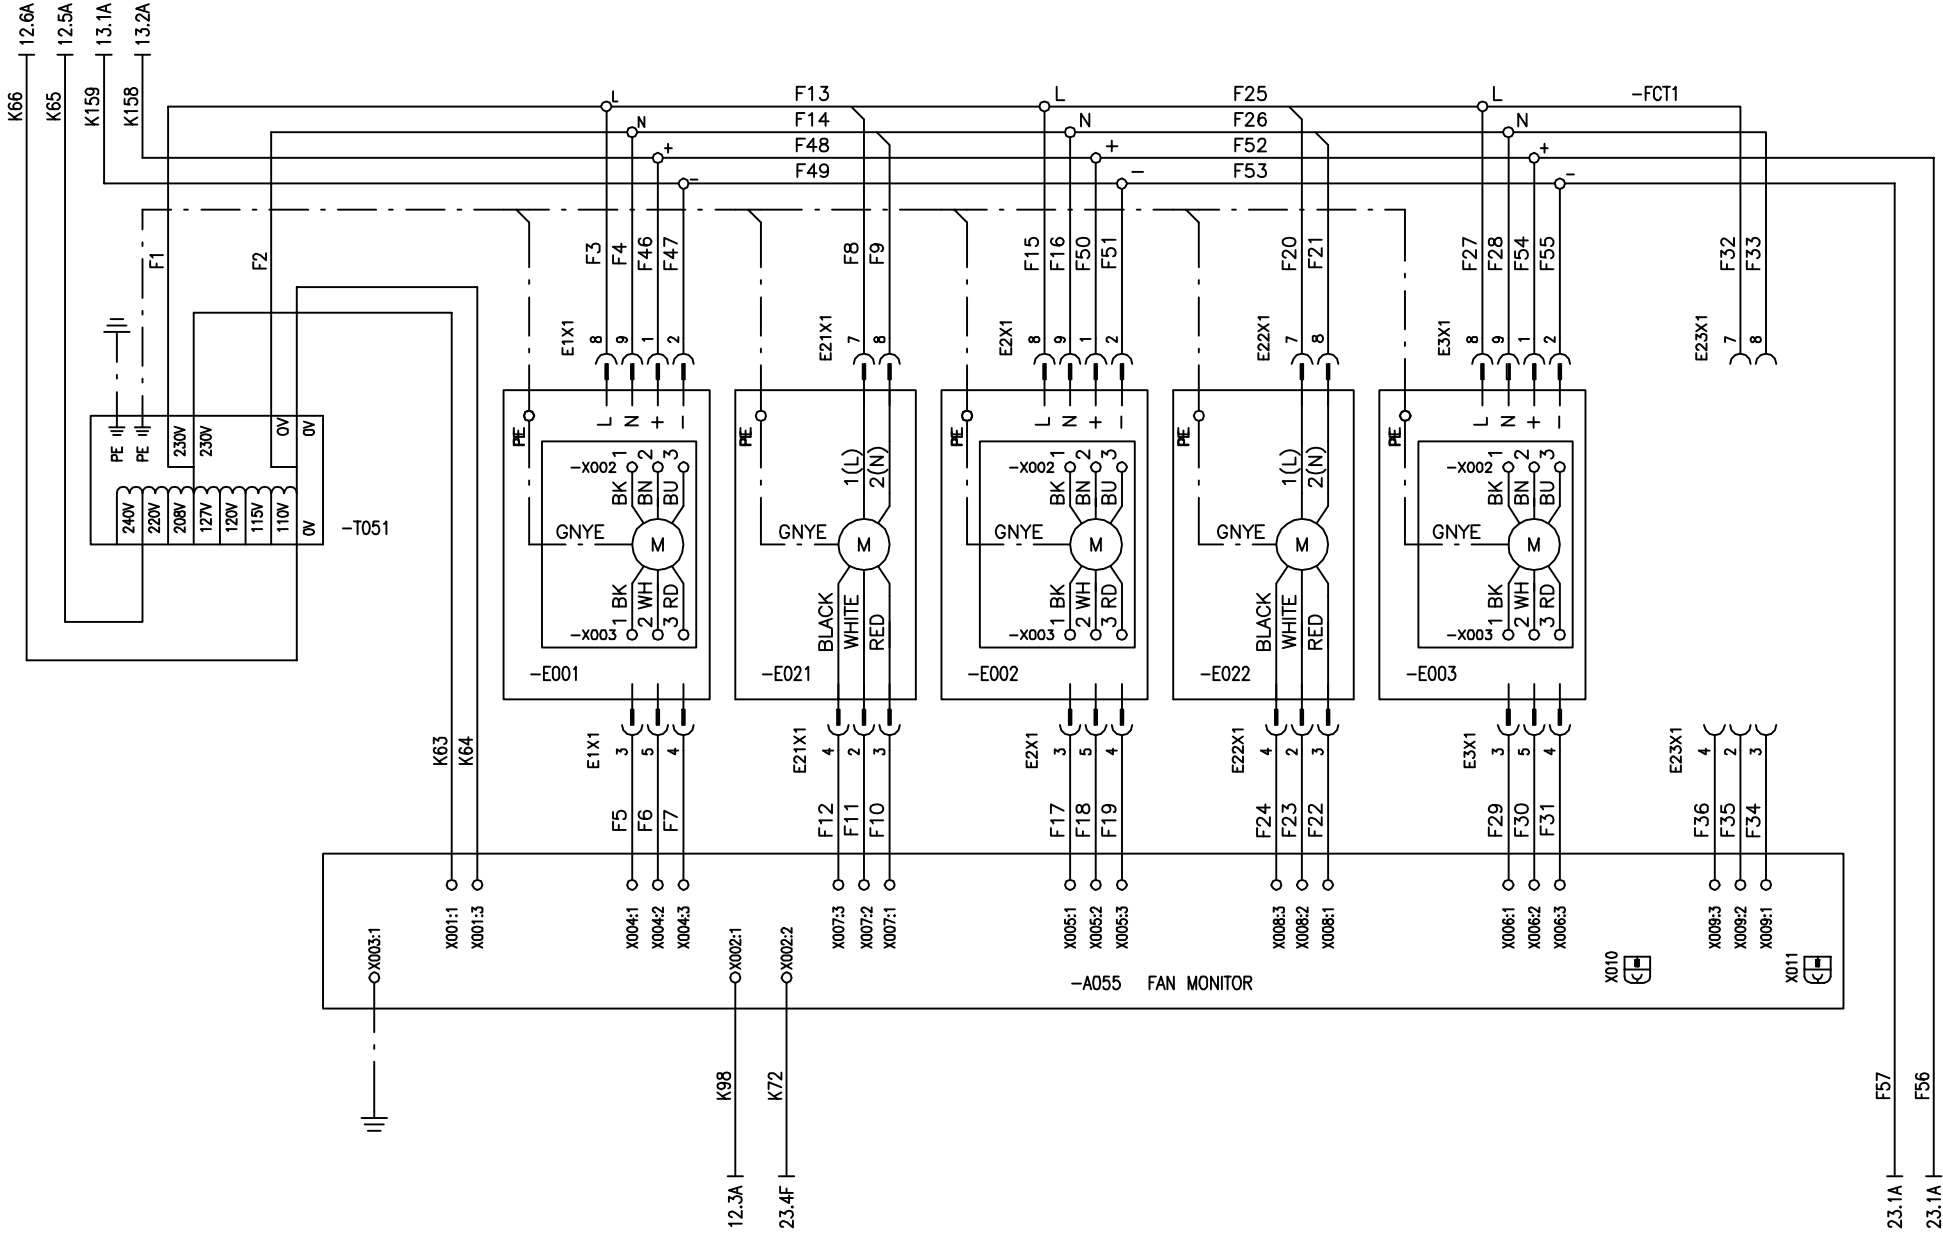

DATE	09.08.10
DRAWN	WWA
DATE	15.11.10
CHECK	HLU

REV. 1 DESCRIPTION 15.11.10 DATE 15.11.10




TYPE : PEW 1060-220/220-EN
WIRING DIAGRAM
UPS

AS BUILT
DOC. NO. 1100322002/00

CHAPTER PAGE
05 22 / 23

RESPECT PROTECTIVE NOTE ISO 16016

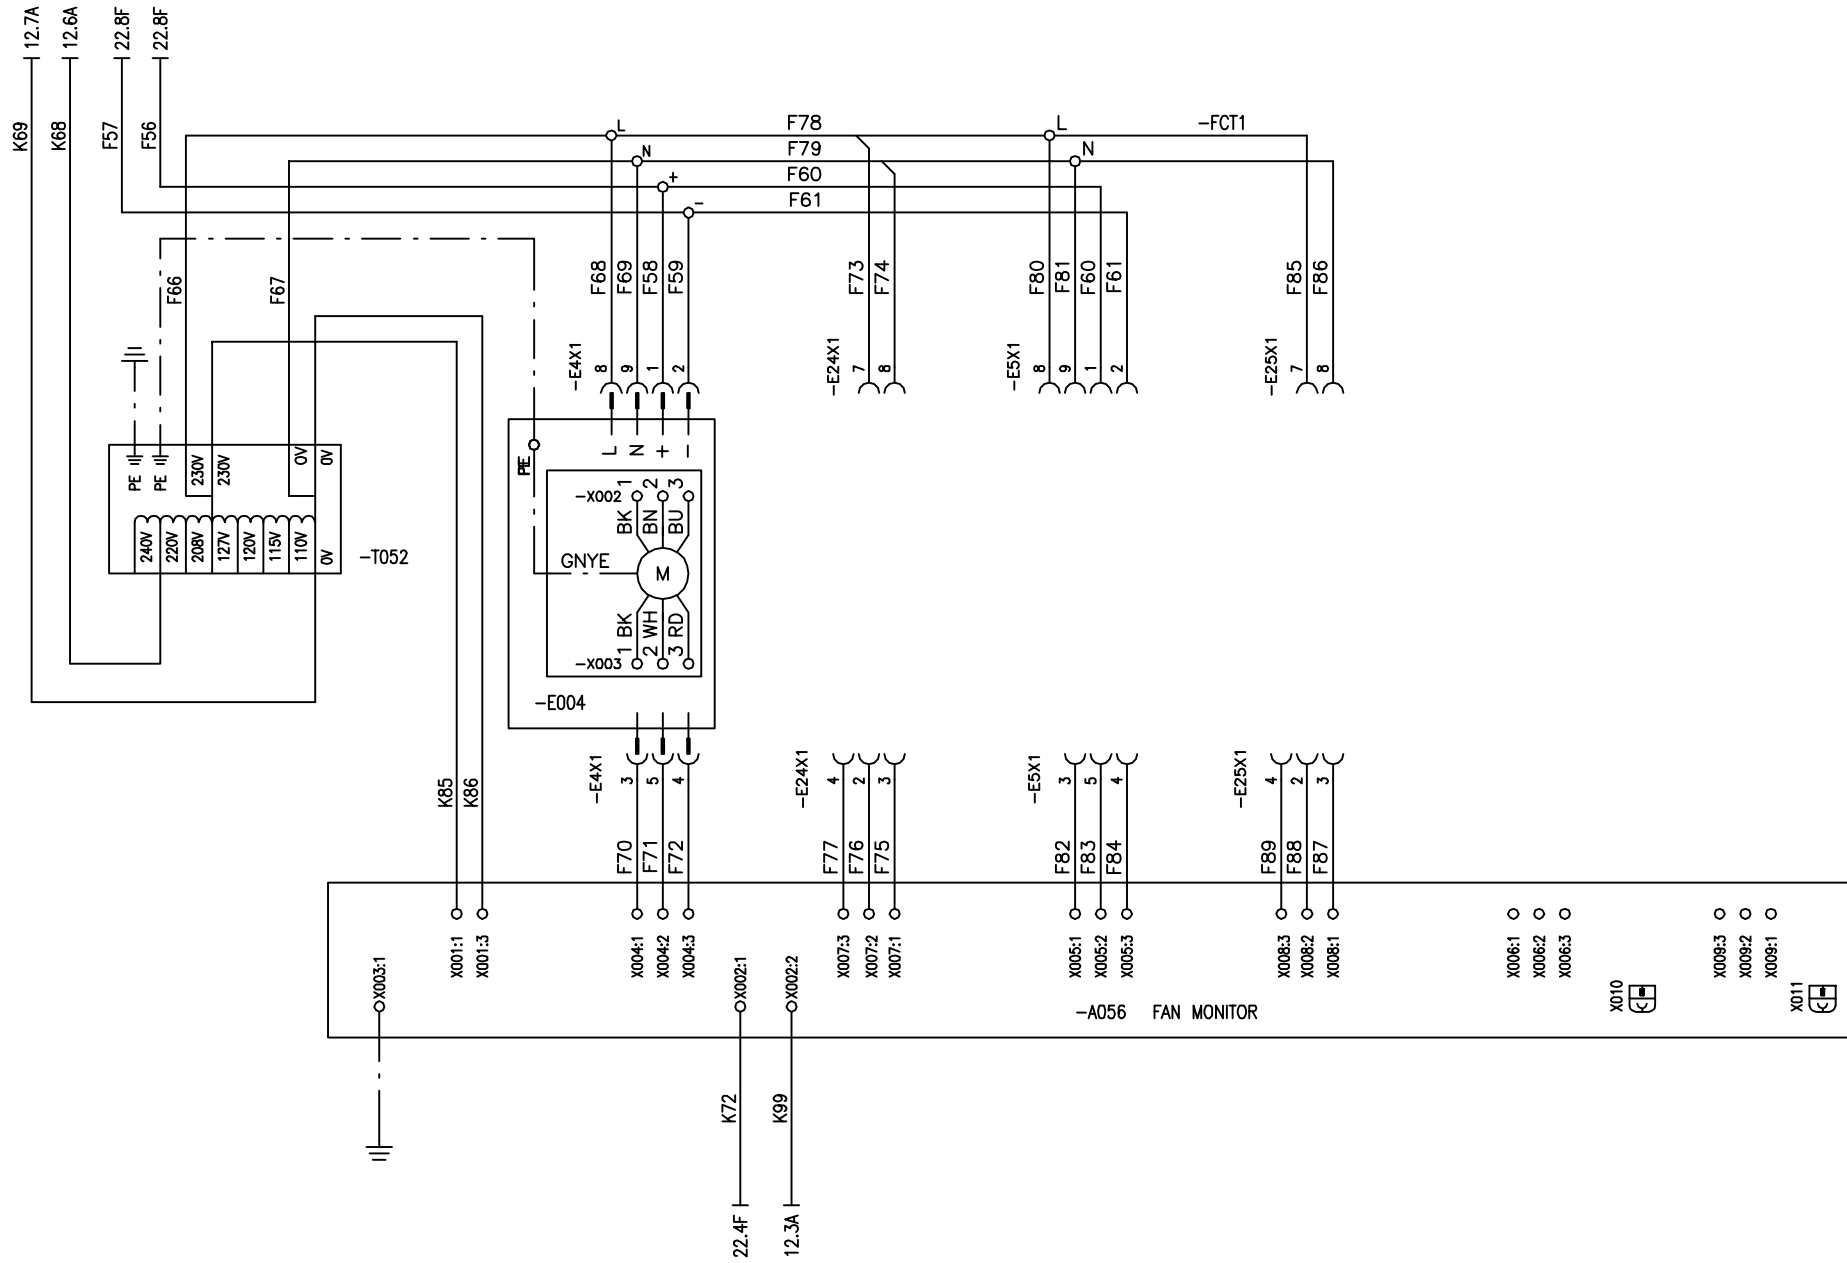

DATE	09.08.10
DRAWN	WWA
DATE	15.11.10
CHECK	HLU


REV. 1 DESCRIPTION DATE NAME CHECK HLU SUBST. FOR : INT. CNT. :



TYPE : PEW 1060-220/220-EN
WIRING DIAGRAM
UPS


AS BUILT
DOC. NO. 1100322002/00

CHAPTER PAGE
05 23 / 23

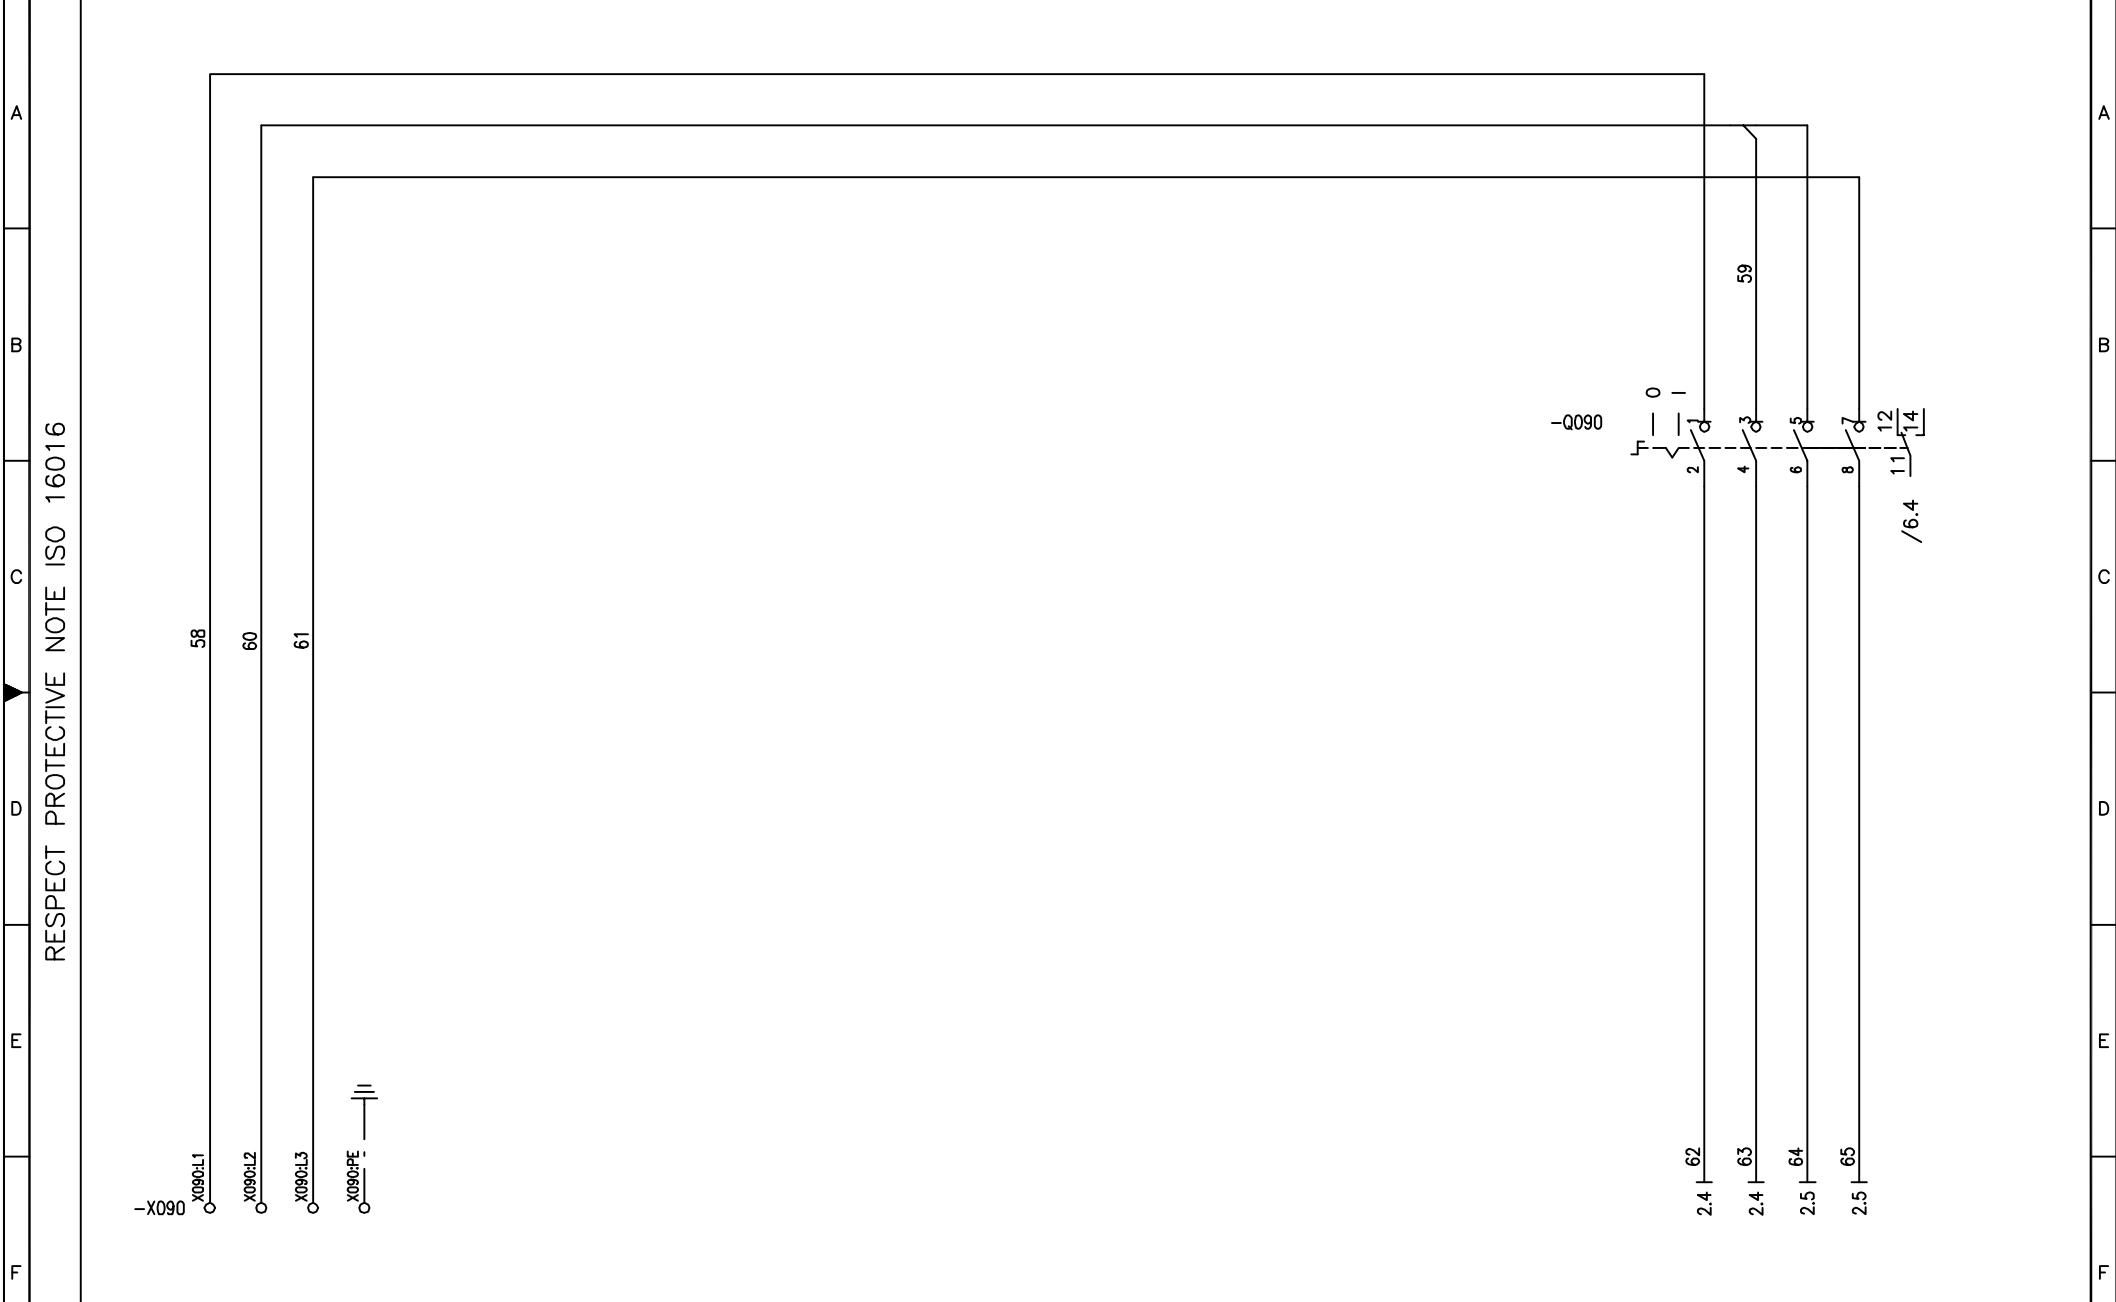

			DATE	09.08.10	GUTOR <small>by Schneider Electric</small>	TYPE : PEW 1060-220/220-EN			AS BUILT	
			DRAWN	WWA		WIRING DIAGRAM				
1	15.11.10	WWA	DATE	15.11.10	INCOMING / BYPASS					
REV.	DESCRIPTION	DATE	NAME	CHECK	HLU	SUBST. FOR :	INT. CNT. :		DOC. NO.	CHAPTER PAGE
									1100322002/00	07 1/6

RESPECT PROTECTIVE NOTE ISO 16016

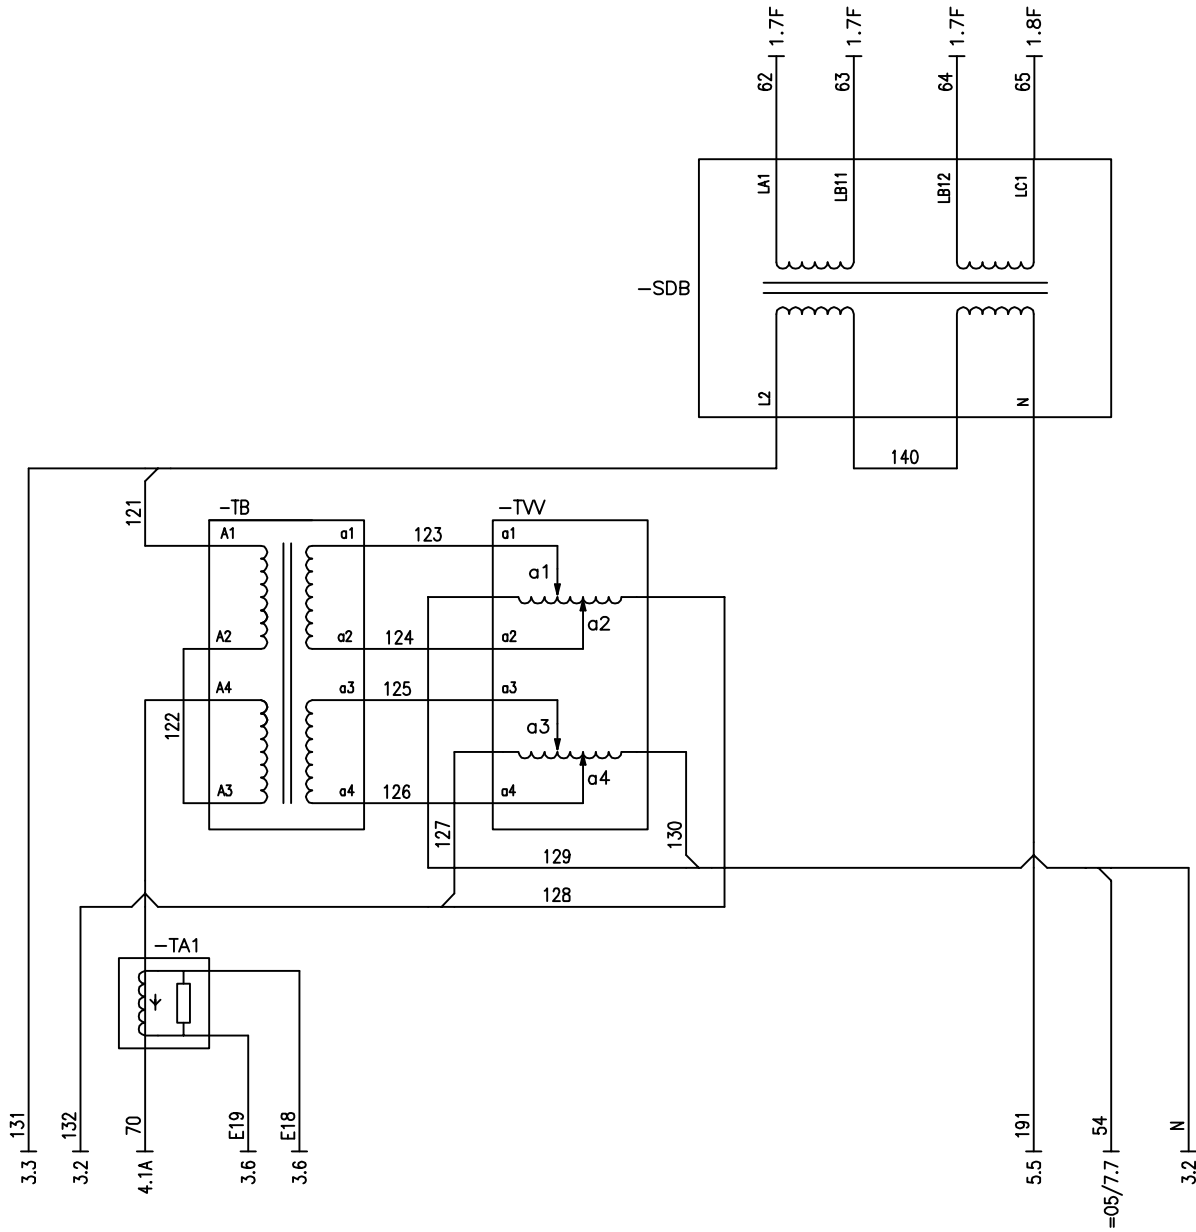

DATE	09.08.10
DRAWN	WWA
DATE	15.11.10
NAME	WWA
CHECK	HLU

GUTOR
by Schneider Electric


TYPE : PEW 1060-220/220-EN
WIRING DIAGRAM
STABILIZER

AS BUILT
DOC. NO. 1100322002/00

CHAPTER PAGE
07 2/6

REV.	DESCRIPTION	DATE	NAME	CHECK	HLU	SUBST. FOR :	INT. CNT. :
1		15.11.10	WWA				

RESPECT PROTECTIVE NOTE ISO 16016

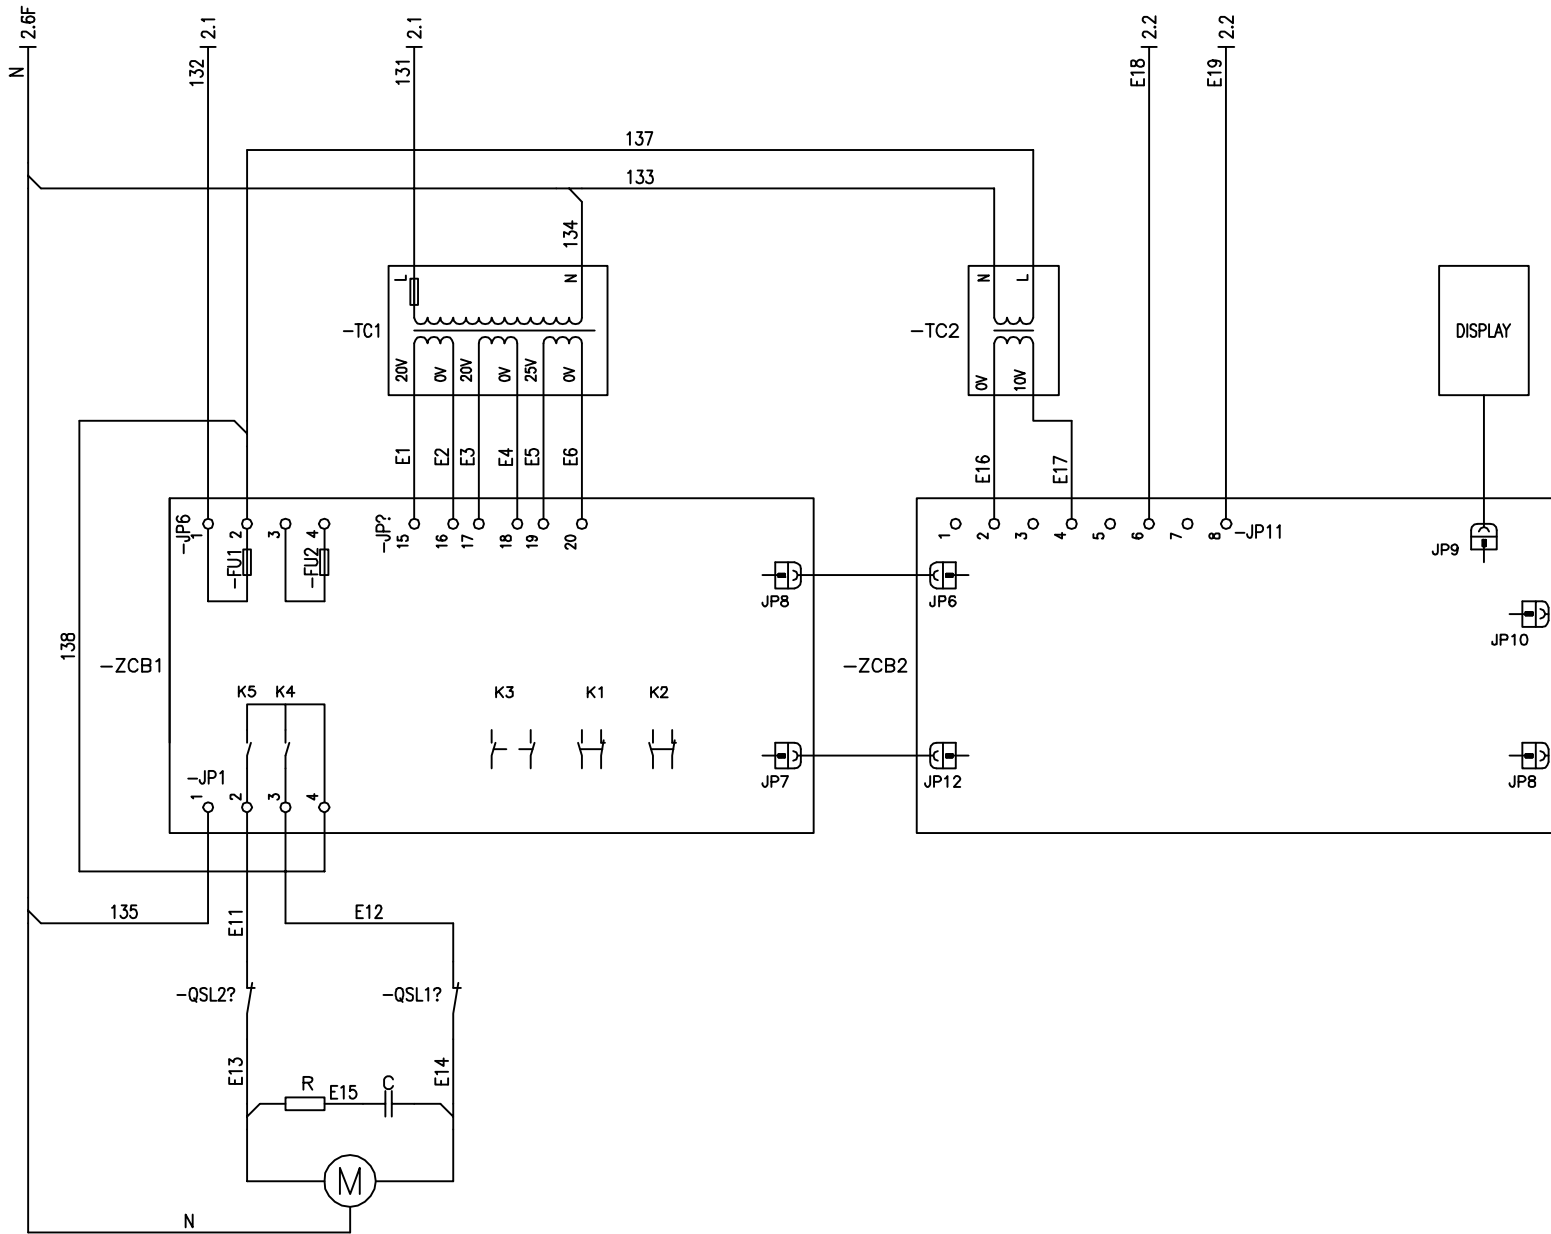

			DATE	09.08.10
			DRAWN	WWA
1	15.11.10	WWA	DATE	15.11.10
REV.	DESCRIPTION	DATE	NAME	CHECK
			HLU	

SUBST. FOR : _____ INT. CNT. : _____


GUTOR
by Schneider Electric

TYPE : PEW 1060-220/220-EN
WIRING DIAGRAM
STABILIZER

AS BUILT
DOC. NO. 1100322002/00

CHAPTER PAGE
07 3 / 6

RESPECT PROTECTIVE NOTE ISO 16016

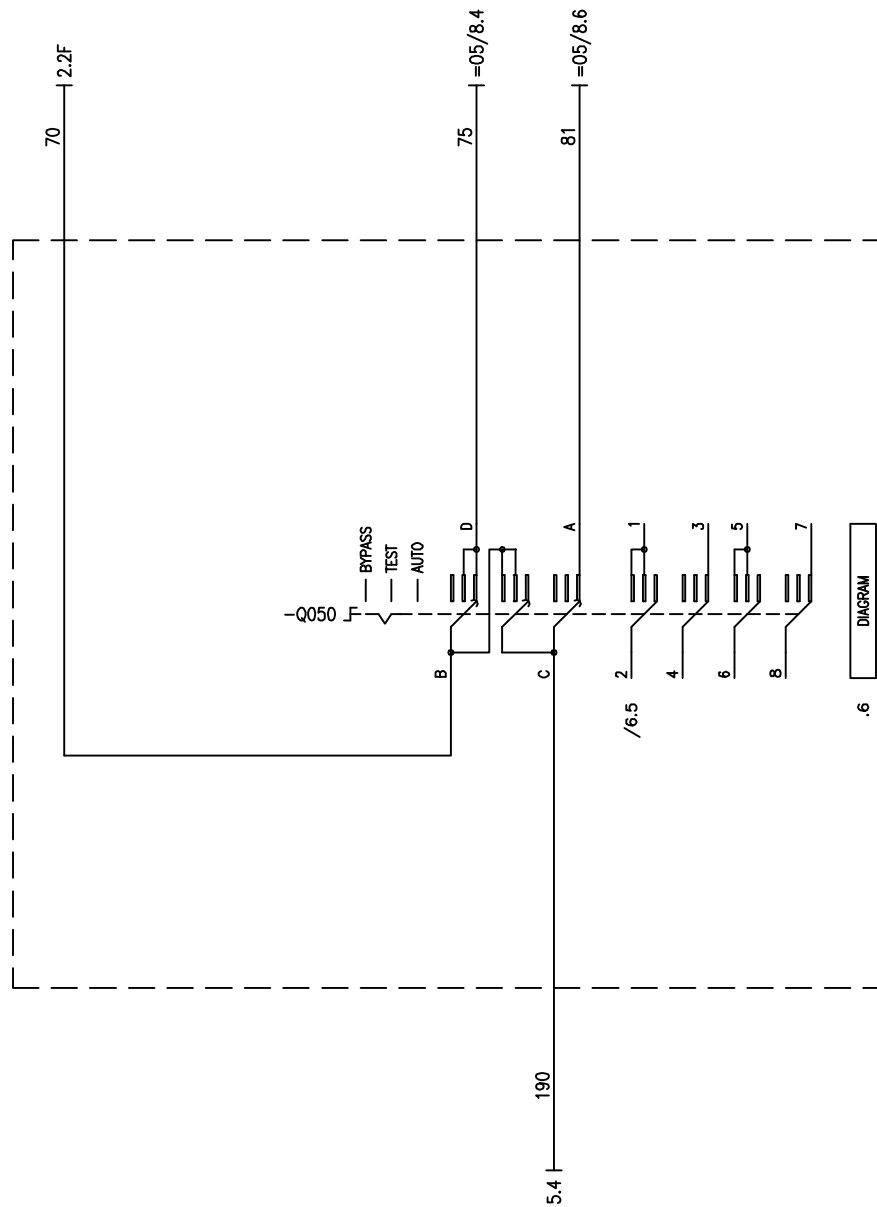

MANUAL BYPASS SWITCH

	.3				540-9155			
	INPUT				AUX.			
	B	C	D	A	B	C	D	A
BYPASS	3	8	2	11	2	1	4	3
TEST					6	5		
AUTO					8	7		


DATE	09.08.10
DRAWN	WWA
DATE	15.11.10
CHECK	HLU



TYPE : PEW 1060-220/220-EN
 WIRING DIAGRAM
 INCOMING / BYPASS

AS BUILT
 DOC. NO. 1100322002/00

1	2	3	4	5	6	7	8
---	---	---	---	---	---	---	---

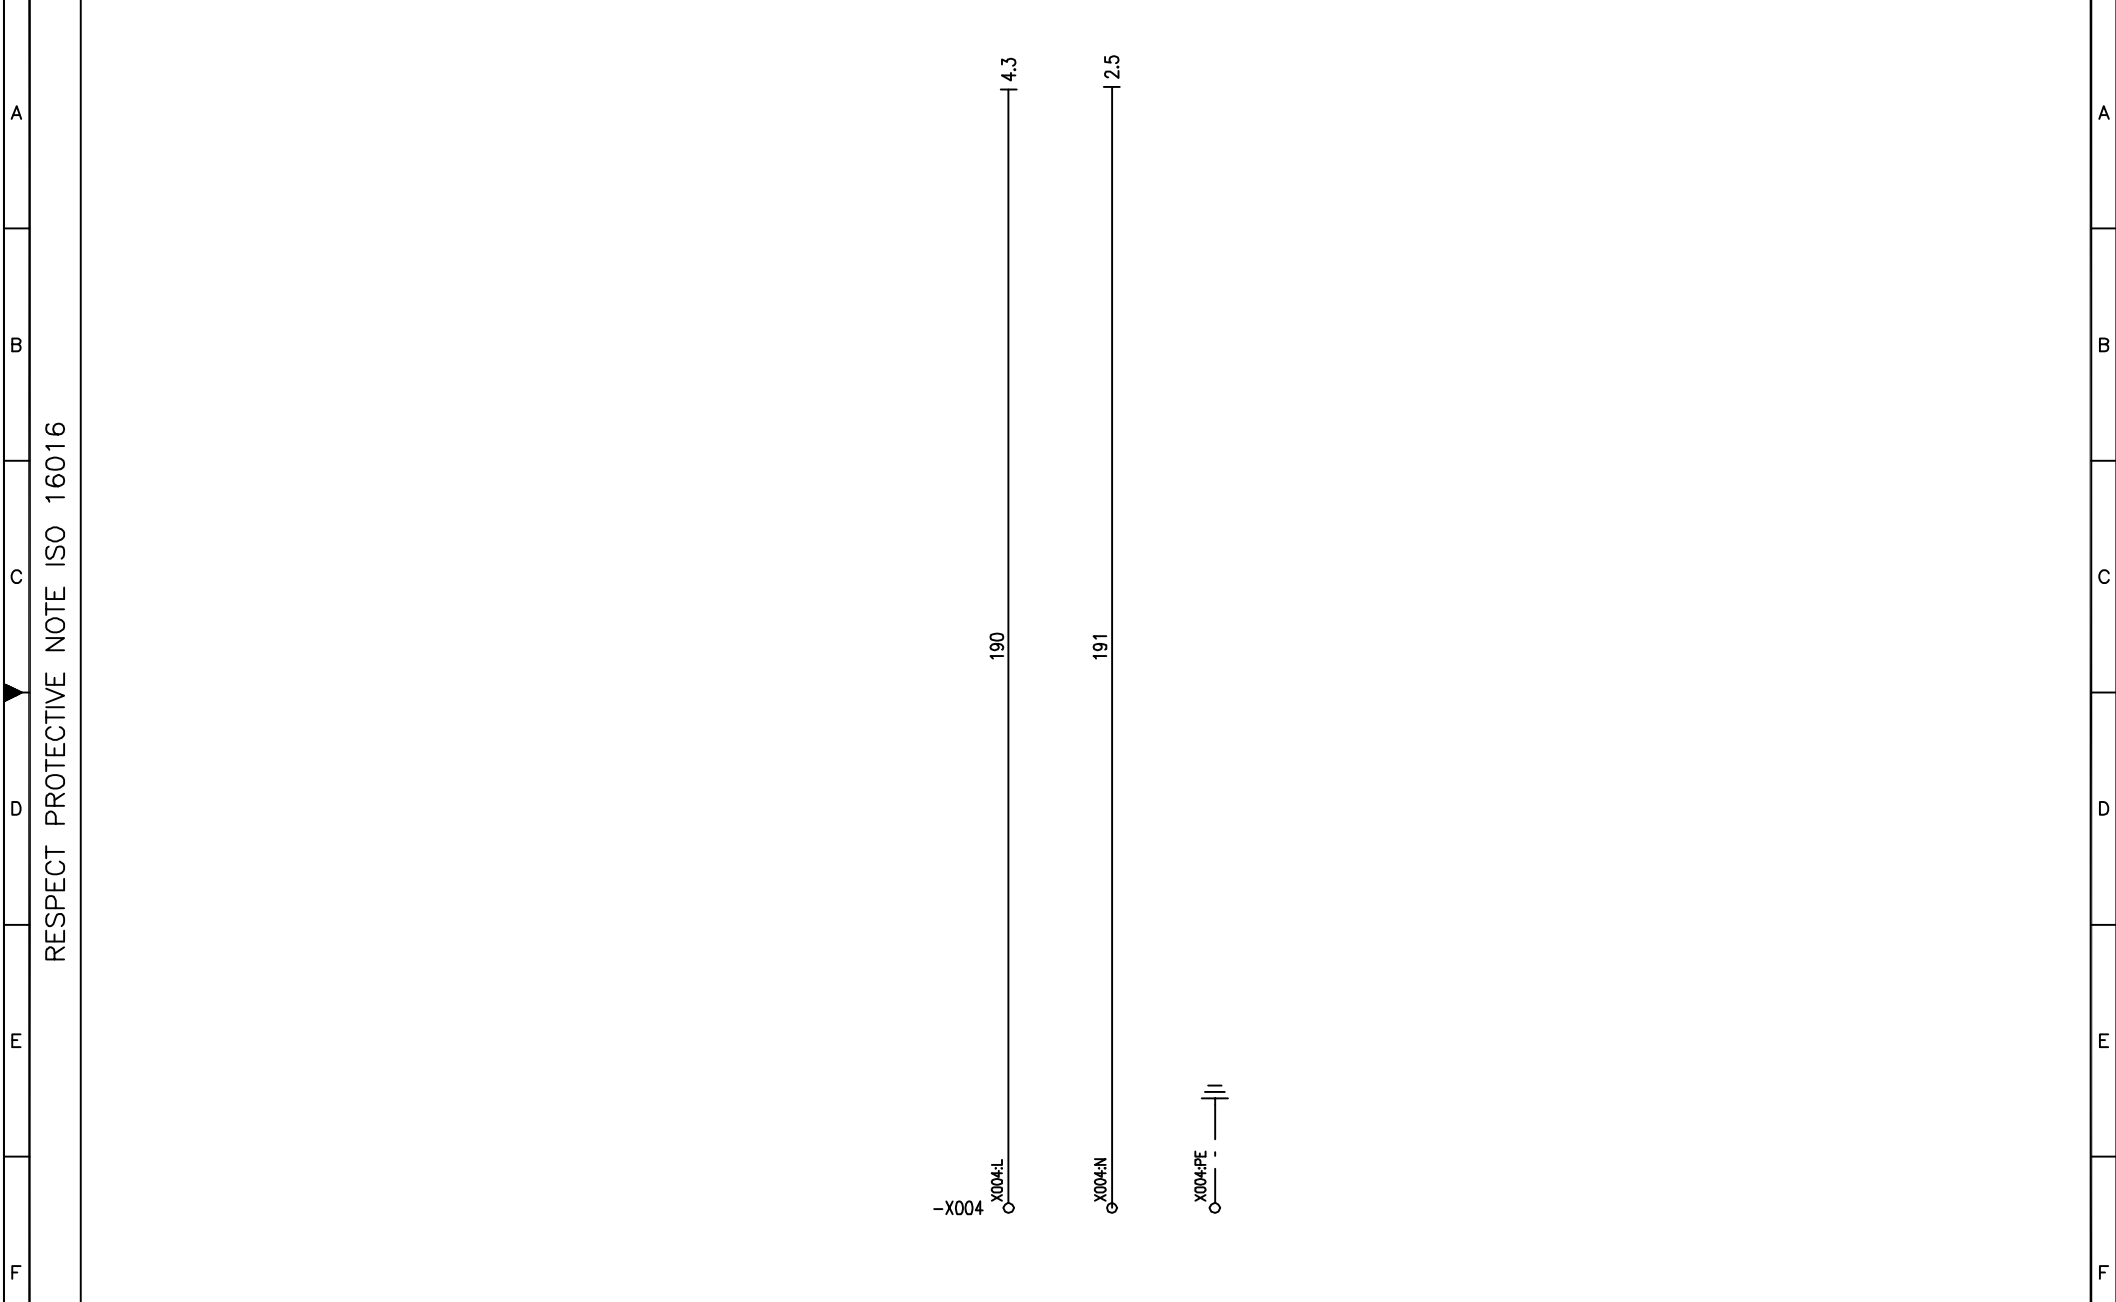


				DATE	09.08.10				TYPE : PEW 1060-220/220-EN			AS BUILT		
				DRAWN	WWA					WIRING DIAGRAM			DOC. NO. 1100322002/00	CHAPTER
1		15.11.10	WWA	DATE	15.11.10					INCOMING / BYPASS				07
REV.	DESCRIPTION	DATE	NAME	CHECK	HLU	SUBST. FOR :	INT. CNT. :							

RESPECT PROTECTIVE NOTE ISO 16016

A
B
C
D
E
F

A
B
C
D
E
F

1	2	3	4	5	6	7	8
---	---	---	---	---	---	---	---

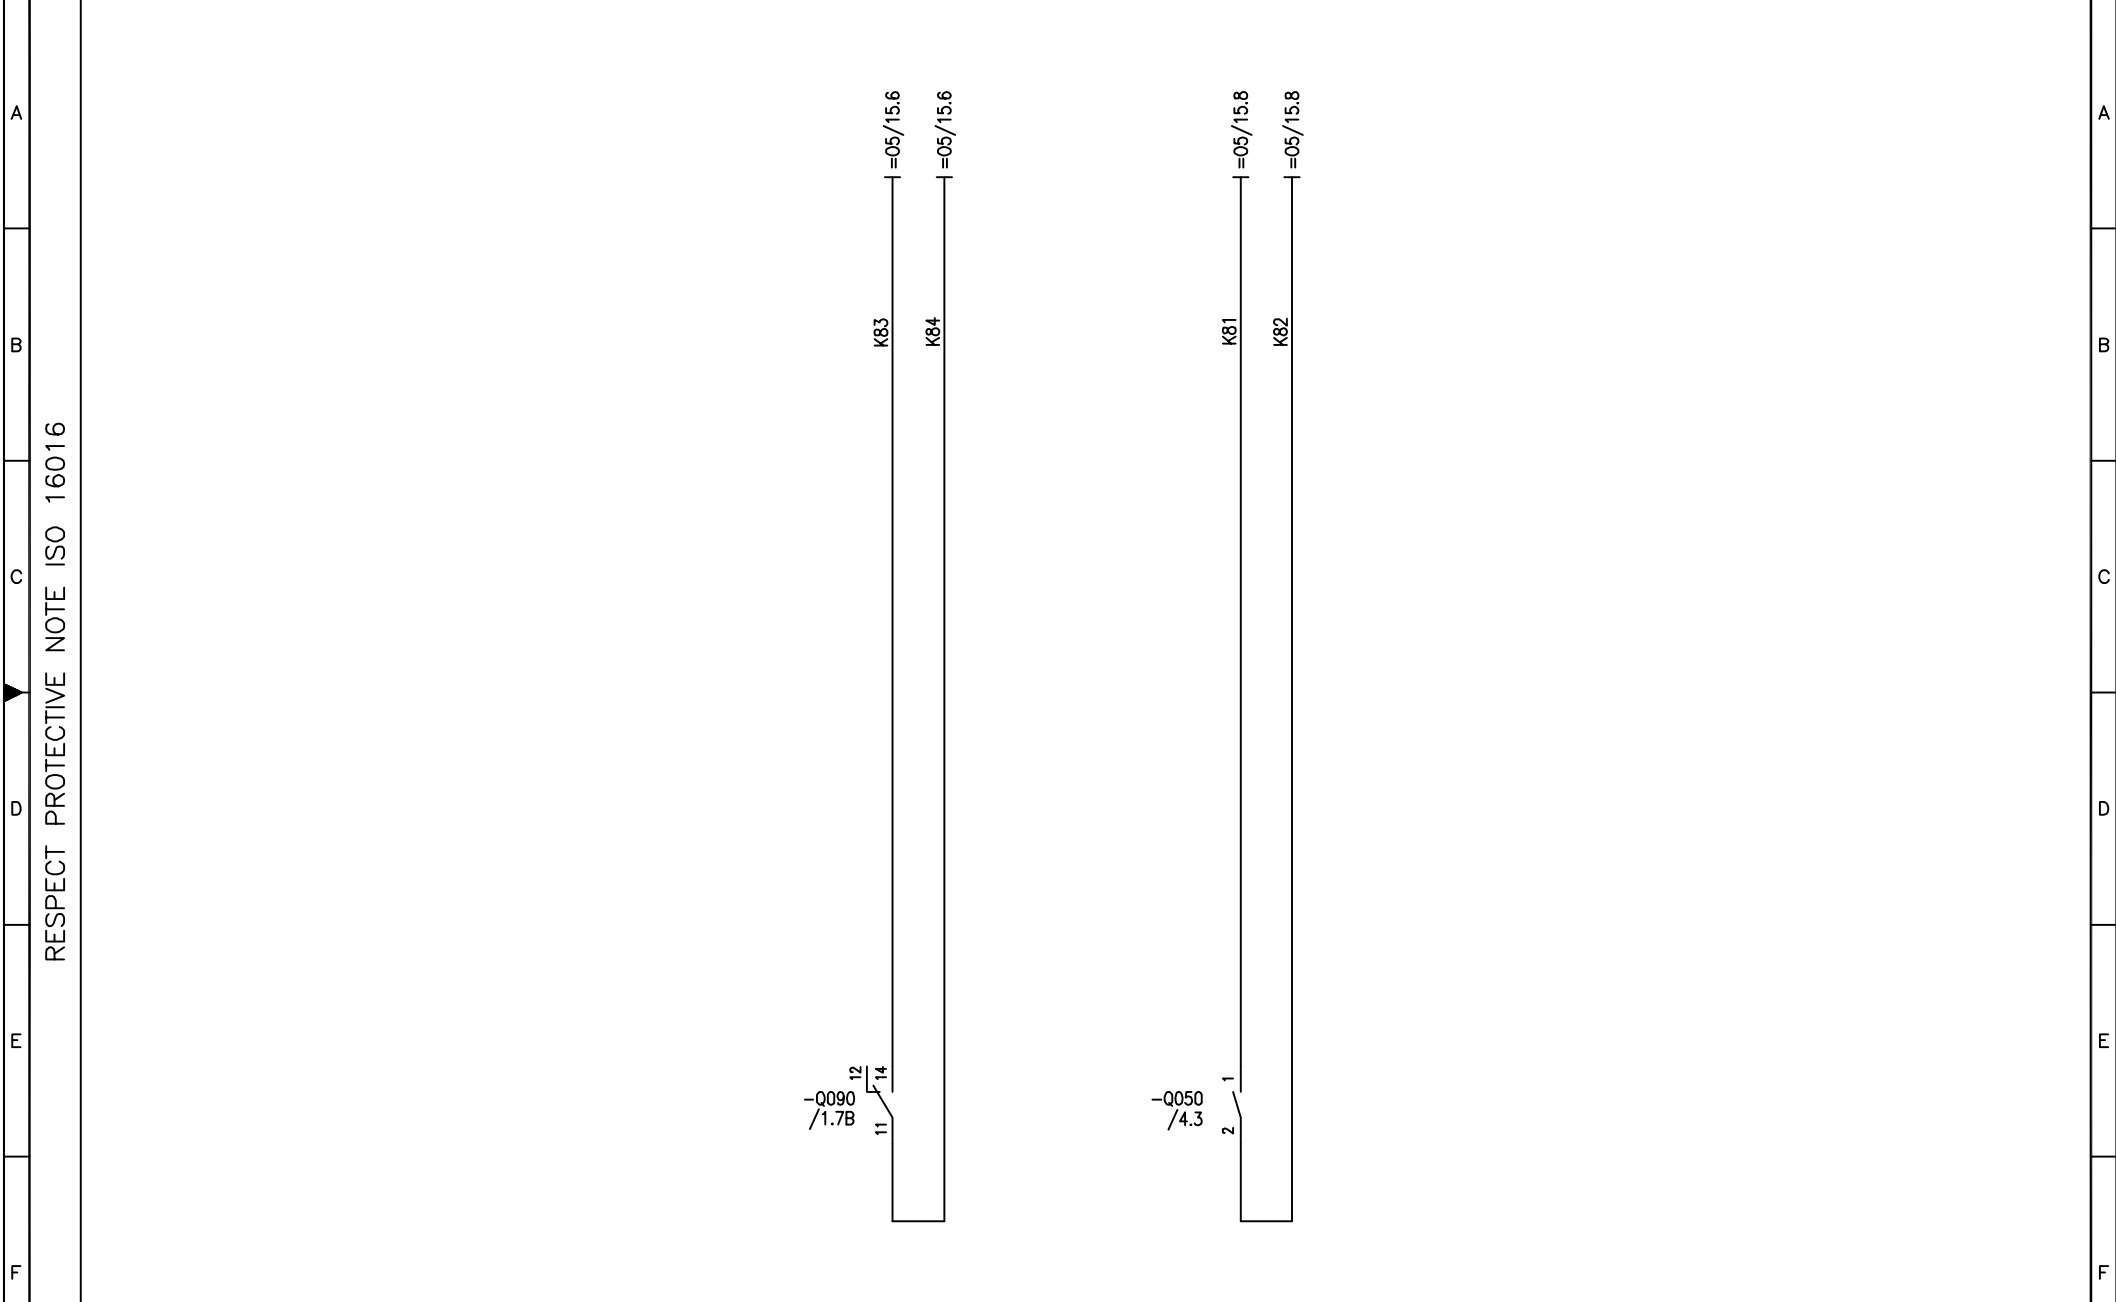

		DATE	09.08.10			TYPE : PEW 1060-220/220-EN		AS BUILT	
		DRAWN	WWA			WIRING DIAGRAM			
1	15.11.10	WWA	DATE	15.11.10			DOC. NO. 1100322002/00		CHAPTER PAGE
REV.	DESCRIPTION	DATE	NAME	CHECK	HLU	SUBST. FOR :	INT. CNT. :	07 6 / 6	

1	2	3	4	5	6	7	8
---	---	---	---	---	---	---	---

Bill of Material 4A-1100322002/50
--

CLIENT: Qingdao Henghua/SBMV PROJECT TITLE: Shandong Haihua Thermal PP SYSTEM TYPE: PEW 1060-220/220-EN	DATE: 16.11.2010 VENDORS NAME: GUTOR
PO No: HB03-10111	SYSTEM No: 1100322002

Item Number	Quantity	Description	Ref. Designator
450-0307A	1	RELAY DC EARTH FAULT TYPE DDEA 20-500VDC	A014
0W3217	1	CABLE HARNESS XXW A014	A014_CT
0M-94010	1	DIODE MODULE PXW IDC=<600ADC	A015
0P9907	1	EXTERNAL CONNECTION BOARD PEW/ PDW	A025
0C0950	1	RECT MODULE PXW 145ADC<IDC=<365ADC	A030
0C0920	1	PM 1/2 24-300VDC 920ARMS/2400APEAK	A032
0C0920	1	PM 1/2 24-300VDC 920ARMS/2400APEAK	A034
0C0075	1	SSW PEW 1~ EN/EA 200AAC<IAC=<450AAC	A035
0P2438	2	FAN MONITOR 8 CH FOR LOW FAN SPEED 120-240VAC	A05x
0P9914	1	ADAPTER BOARD 40POL	A068
0P2446	1	PCB CONTROLLER XXW 3PH/1PH, 5US BT, 2KHZ PWM	A070
0P2405	1	INTERFACE FUSE FC UPS 220VDC W.O. T1...T12	A071
430-0048A	3	XFMR SAF ISOL -15% 216-251VAC+10% IEC/UL	A071
110-0000	1	R ORO 5A RES.	A071_IJ22
430-0048A	1	XFMR SAF ISOL -15% 216-251VAC+10% IEC/UL	A071_T006
430-0048A	1	XFMR SAF ISOL -15% 216-251VAC+10% IEC/UL	A071_T009
0P0363	1	SIGNALIS. CONTROLLER	A072
0M-94035A	1	FRONTPANEL COMPLETE	A073
0P9894	1	COMM. INTERFACE RS485 FOR CONT.	A076
0P9912A	1	RELAY BOARD 24VDC 16 RELAY PEW/PDW	A077
0P9912A	1	RELAY BOARD 24VDC 16 RELAY PEW/PDW	A078
0P0280	1	PSU, AC SUPPLY OUT:+20VDC/+12VDC/+5VDC	A201
0P0284	1	PSU 220VDC OUT:+20VDC/+12VDC/+5VDC	A202
0M-94103	1	CB02 M.KIT5 (ALU) 8-21 CAPACITORS	CB02
0M-94106	2	CB02 M.KIT8 (ALU) CONNECT. TO LARGE PM	CB02
202-3682	20	CE 6800MF 350VDC STUD	CB02
803-0090	20	NUT NYLON M12 PYB7042	CB02
0N-0948	2	ASSY XXW CB02 DISCHARGE RESISTORS 3KOHM	CB02_R006
LM149		XXW- CB02 - DISCHARGE RESISTORS - ASSEMBLY	CB02_R006_Layout
234-0117	18	CS 110MF 250VAC/ HPFNT B.TAP UL	CB03
0W2367A	18	WIRE CB03 BRIDGE	CB03_CT1
0W2369A	12	WIRE SET CB03 1 SHORT	CB03_CT2
0W2368A	6	WIRE SET CB03 1 LONG	CB03_CT3
LM15_41		MEI ASSY_LAYOUT_CB03_1 PH_Y	CB03_LAYOUT
0M-10069	1	CB03 MECH. KIT PLATE 375-1P	CB03_MECH_1
0P6246	1	CT AC 110A<INV=<140A 110A<REC<=210A	CB03_P016
0M-8190	4	SUB ASSEMBLY FAN 230VAC DUAL SPEED XXW	E00x
0M-94028	2	SUB ASSEMBLY FAN 230 VAC FOR ROOF XXW	E02x
515-9028	1	SEMIC.FUSE 500A/250VFWX UL/CSA	F021
0M-94050	1	INDICATOR FOR FWX FUSE 225A-800A	F021_Ind
0M-94146	1	FUSE.KIT07 1PH SSW3 EN	F021_Kit
515-9031	2	SEMIC.FUSE 800A/250VFWX UL/CSA	F028
870-93018	2	MOUNT PLATE PXW MOD.DISTANCE 35MM	FBOX_Pos4
870-10607	1	MOUNT PLATE PXW MODULE DISTANCE 40MM	FBOX_Pos5
870-10575A	2	COVER FANBOX 200 X 148	FBOX_Pos6

Bill of Material 4A-1100322002/50
--

CLIENT: Qingdao Henghua/SBMV	DATE: 16.11.2010
PROJECT TITLE: Shandong Haihua Thermal PP	VENDORS NAME: GUTOR
SYSTEM TYPE: PEW 1060-220/220-EN	
PO No: HB03-10111	SYSTEM No: 1100322002

Item Number	Quantity	Description	Ref. Designator
870-10606	1	MOUNT PLATE PXW MODULE DISTANCE 345MM	FBOX_Pos9
420-9326	1	DC-CHOKE 264 316 922	L001
430-0629	1	AC.CH.XEW1060 2KHZ 220VDC	L002
420-9206	1	BATT.-CHOKE 315ADC/500VDC	L005
0P9882	1	DATA CONVERTER RS232 / RS485	LVC_A075
0P6234	1	CT AC 140A<INV=<170A 135A<REC=<260A	P004
0P6234	1	CT AC 140A<INV=<170A 135A<REC=<260A	P005
0P6234	1	CT AC 140A<INV=<170A 135A<REC=<260A	P006
0P6285A	1	CT DC 296A<IDC=<324A 444A<IDISCH=<485A	P007
0M-94088	1	DC CURRENT MEASURE XXW MECH. IDC >186A	P007_P009
0P6284A	1	CT DC 281A<IDC=<296A 421A<IDISCH=<444A	P009
0P6240	1	CT AC 480A<INV=<600A470A<REC=<900A	P010
0P6236	1	CT AC 260A<INV=<310A 260A<REC=<470A UL	P013
234-0335	1	CAP MTL PPR 400V 5% 3UF RD	PF_1CB4
540-0262	1	LOAD SWITCH 3P 250A 690VAC/63VDC INS250 MG	Q001
530-1229	1	MCCB DC 4P 200ADC 500V/100KA NS250DC MG	Q004
540-0274	1	AUX/TRIP CONTACT MCCB+LOAD SWITCH (1CO) MG	Q004_AUX
540-9155	1	BYPASS MAN. SW. 1P. 3POS 500A 2AX NO.NC	Q050
540-0268	1	LOAD SWITCH 4P 160A 690VAC/63VDC INS160 MG	Q090
UNC1-432-3780	1	TRAFO IN 98KVA 380V ACC 1100322002/19	T001
430-9804	1	INV.TR.M.XEW1060 2X63/220-240	T002
0M-94081	1	PSU TRAFO SUB.ASS. 208V-20% / 240V+20%	T004
0M-94084	1	PSU TRAFO SUB.ASS. 380V-20% / 460V+20%	T005
430-9521	2	AUTOTR. 110-240/230V 500VA	T05x
UNC1-432-3789	1	STABILIZER BYP 72.2KVA ACC 1100322002/37	T090
340-0025	1	DIODE H 480A/1200V	V015
730-0912	3	TERMINAL BOLT M8 70MM2 WFF 70	X001
0M-10487	2	TERMINAL 2X240MM2 CU 40X8MM	X002
730-0914	2	TERMINAL BOLT M12 185MM2 WFF 185	X004
730-0913	3	TERMINAL BOLT M10 120MM2 WFF 120	X090
0P9895	1	LOADED PCB RFI F. MAINS BYP. OR OUTP 480V 3PH	Z001
410-0900	1	FERRITE CLIP-ON RND ROUND CABLE	Z070
410-0900	1	FERRITE CLIP-ON RND ROUND CABLE	Z071
410-0900	1	FERRITE CLIP-ON RND ROUND CABLE	Z072
410-0900	1	FERRITE CLIP-ON RND ROUND CABLE	Z073

Mechanical parts, UPS Cubicle

UNC1-870-9240	1	CUBICLE ACC 1100322002/14	CUBICLE
870-92617	2	BASECOVER FRONT/REAR 775MM	FR1_IPK_B1_P1
822-0038	8	FASTENER SOCKET GRID	FR1_IPK_B1_P2
870-92644	2	BASE COVER 400MM	FR1_IPK_B1_P3
870-92928	1	SOIL GRID IP20 630X690	FR1_IPK_B2_P1
870-92925	1	SOIL GRID IP20 300X690	FR1_IPK_B2_P2
870-92612	1	TOP COVER 1150X800MMIP20	FR1_IPK_T1_P1
0M-94033	1	S/A FRAME 1150X750X1800	FR1_UPS

Bill of Material 4A-1100322002/50
--

CLIENT: Qingdao Henghua/SBMV PROJECT TITLE: Shandong Haihua Thermal PP SYSTEM TYPE: PEW 1060-220/220-EN	DATE: 16.11.2010 VENDORS NAME: GUTOR
PO No: HB03-10111	SYSTEM No: 1100322002

Item Number	Quantity	Description	Ref. Designator
0M-5469	1	KIT UPS M FOR FRAME 1150 1800	FR1_UPS_MKIT
0M-94047	1	S/A FRAME 400X750X1800	FR3_INC
0M-5778	1	KIT INC M BASIC FOR FRAME WIDTH 400	FR3_INC_MKIT
870-92644	2	BASE COVER 400MM	FR3_IPK_B1_P1
822-0038	4	FASTENER SOCKET GRID	FR3_IPK_B1_P2
870-93032	1	SOIL GRID IP20 255X345	FR3_IPK_B3_P1
870-92914	1	GLAND PLATE ALU 255X345	FR3_IPK_B3_P2
870-92643	1	TOP COVER 400X800MMIP20	FR3_IPK_T1_P1
0M-94034	1	S/A FRAME 775X750X1800	FR5_1_BYP
0M-0114	1	KIT BYP M FOR FRAME WIDTH 775	FR5_1_BYP_MKIT
870-92617	2	BASECOVER FRONT/REAR 775MM	FR5_1_IPK_B1_P1
822-0038	4	FASTENER SOCKET GRID	FR5_1_IPK_B1_P2
870-93036	1	SOIL GRID IP20 630X345	FR5_1_IPK_B3_P1
870-92917	1	GLAND PLATE ALU 630X345	FR5_1_IPK_B3_P2
870-92613	1	TOP COVER 775X800MMIP20	FR5_1_IPK_T1_P1
0M-94047	1	S/A FRAME 400X750X1800	FR5_2_BYP
870-92644	2	BASE COVER 400MM	FR5_2_IPK_B1_P1
822-0038	4	FASTENER SOCKET GRID	FR5_2_IPK_B1_P2
870-93032	1	SOIL GRID IP20 255X345	FR5_2_IPK_B3_P1
870-92914	1	GLAND PLATE ALU 255X345	FR5_2_IPK_B3_P2
870-92643	1	TOP COVER 400X800MMIP20	FR5_2_IPK_T1_P1
Software			
PD300-041	1	DMU R03 986-0200.HEX	A070_DMU
PD300-004P	1	MPU R12.1 PROGRAMMABLE LOADPROFILES 986-1288P.HEX	A070_MPU
PD300-005E	1	RAM1 R08.3 ENGLISH, GERMAN, 986-0213E.BIN	A070_RAM1
351-0003	1	SRAM 8KX8 RTC - BATT200NS	A070_RAM2
PD300-040D	3	VQ R07.3, 986-1119.HEX	A070_VQ